


CERTIFIED RECORD OF LAND CORNER MONUMENTATION

History of original corner establishment:

Corner established by W. B. Barr under GLO Contract No. 443 dated May 29, 1882.

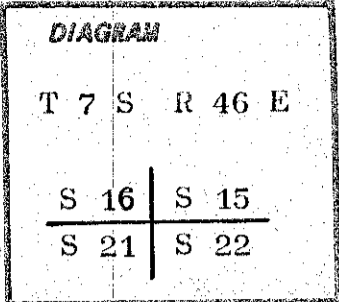


Surveyor General's records state:

Set post 4 ft long 4 ins diam 24 ins in ground for corner to Sec 15, 16, 21, 22 marked T 7 S S 15 on the NE face, R 46 E S 22 on the SE face, S 21 on the SW face and S 16 on the NW face with 3 notches on the S and E edges, from which:

- A fir 14 ins diam bears N 71° E 09 lks dist mkd T 7 S R 46 E S 15 BT
- A fir 03 ins diam bears N 03° W 47 lks dist mkd T 7 S R 46 E S 16 BT
- A fir 16 ins diam bears S 35° W 28 lks dist mkd T 7 S R 46 E S 21 BT
- A fir 15 ins diam bears S 33° E 17 lks dist mkd T 7 S R 46 E S 22 BT

Description of corner evidence found:

A 2½ in. aluminum cap on a 1 in. iron pipe 31 ins. long and projecting 3 ins. out of the ground marked thus:

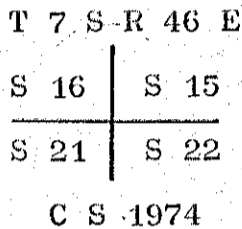

A fir 30 ins. diam. bears S 35° W., 18.5 ft. (28 lks) dist. with visible scribes on previously opened blaze for Section 21 bearing tree.  
 A fir 24 ins. diam. (windblow) with visible scribes for Section 22 BT.

Description of monument and accessories established to perpetuate the original location of this corner:

Raised a surrounding rock mound around the corner monument and set a 6 foot steel fence post 4 feet east with a sign 54-4 and 54-2 attached.

New bearing trees:

- A fir 10 ins. diam. bears N 82° E, 56.5 ft. dist. mkd T 7 S R 46 E S 15 BT
- A fir 30 ins. diam. bears S 47° E, 52.0 ft. dist. mkd T 7 S R 46 E S 22 BT
- A fir 6 ins. diam. bears N 63° W, 24.5 ft. dist. mkd T 7 S R 46 E S 16 BT

The original bearing trees have a sign 54-3 attached below a band of red paint and the new bearing trees have a sign 54-3 attached below a band of red paint and have a brass washer marked LS 1639 nailed flush with BT blaze.

I hereby certify that the above corner monument was properly perpetuated by me on Sept. 3, 1979 and witnessed by Jim DeMastus.

**REGISTERED  
PROFESSIONAL  
LAND SURVEYOR**

*William L Hanley*

**OREGON  
JULY 14, 1978  
WILLIAM L. HANLEY  
1639**

Office of..... County of.....  
 State of....., I hereby certify that the within instrument was filed in this office  
 for record on the..... day of....., 19.....

..... by .....

(COUNTY OFFICIAL)

(DEPUTY)

Form R6-7100-57 (9/71)

FILED OCT. 24, 1979  
 BAKER COUNTY SURVEYOR  
 SURVEY NO. 7-46-72