

CERTIFIED RECORD OF LAND CORNER MONUMENTATION


History of original corner establishment:

Corner established by W. B. Barr under GLO contract No. 443 dated May 29, 1882.

Surveyor's General records state:

Set a basalt rock 12 x 10 x 5 ins 8 ins in the ground for 1/4 sec corner marked 1/4 on the North side, from which;

A pine 8 ins diam bears S 36° E, 115 lks dist marked 1/4 S BT
A pine 20 ins diam bears N 48° E, 100 lks dist marked 1/4 S BT

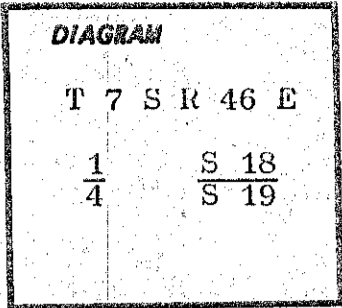

Description of corner evidence found:

A fallen stump 24 ins. diam. with full scribes for section 18 record bearing tree.

Description of monument and accessories I established to perpetuate the original location of this corner:

Set a 2½ in. brass cap on a 1 in. iron pipe 31 ins. long projecting 5 ins. out of the ground with a surrounding rock mound.

Brass cap marked thus: T 7 S R 46 E

$\frac{1}{4}$ $\frac{S\ 18}{S\ 19}$

CS 1979

New bearing trees:

A pine 19 ins. diam. bears N 01° E, 76.2 ft. dist. marked 1/4 S 18 BT
A fir 16 ins. diam. bears S 46° E, 88.3 ft. dist. marked 1/4 S 19 BT

I hereby certify that the above corner monument was properly re-established under my supervision on November 20, 1979 and witnessed by Brad Gordon, Jim DeMastus and Tom Fisk.

REGISTERED
PROFESSIONAL
LAND SURVEYOR

James D. Hanley
OREGON
SEPTEMBER 23, 1977
JAMES D. HANLEY
1206

Office of..... County of.....
State of....., I hereby certify that the within instrument was filed in this office
for record on the..... day of....., 19.....

..... by
(COUNTY OFFICIAL) (DEPUTY)

FILED Nov. 23, 1979
BAKER COUNTY SURVEYOR
SURVEY NO. 7-46-76