

**CERTIFIED RECORD OF LAND CORNER MONUMENTATION**


History of original corner establishment:

Corner established by W. B. Barr under GLO contract no. 443 dated May 29, 1883.

Surveyor General's records states:

Set basalt stone 15 x 12 x 5 ins 10 ins in the ground for cor to Secs 19, 20, 29 and 30 marked with 2 notches on the south and 5 notches on the east edges from which:

- A pine 6 ins diam bears N 09° E, 95 lks dist marked T 7 S R 46 E S 20 BT
- A pine 7 ins diam bears N 89° W, 265 lks dist marked T 7 S R 46 E S 19 BT
- A pine 16 ins diam bears S 59° W, 187 lks dist marked T 7 S R 46 E S 30 BT
- A pine 5 ins diam bears S 55° E, 180 lks dist marked T 7 S R 46 E S 29 BT

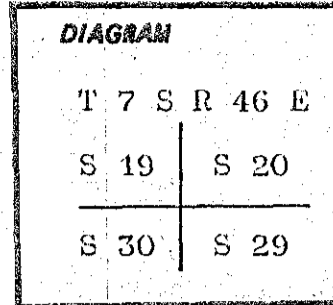

Description of corner evidence found:

Found a basalt stone 15 x 12 x 5 inches with 5 notches on the east edge, and the following original accessories:

- A pine 18 inches diameter for the Section 20 BT with no visible scribes,
- A rotten stump with visible scribes for Section 30 BT.
- No trace found of Sections 19 and 29 bearing trees in previously logged area.


Description of monument and accessories established to perpetuate the original location of this corner:

Set a 2½ inch brass cap on a 1 inch iron pipe 31 inches long with a surrounding rock mound. The original stone was placed in the mound.

Brass cap marked thus:

T 7 S R 46 E	
S 19	S 20
<hr style="width: 50%; margin: 0 auto;"/>	
S 30	S 29
CS 1977	

I hereby certify that the above corner monument was properly re-monumented on Sept. 27, 1977 and witnessed by Bill Hanley and Rob Miller.

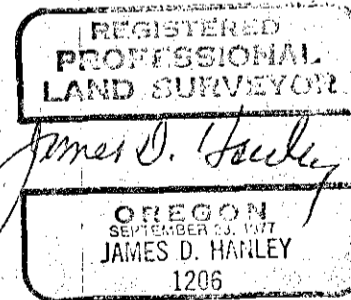

Office of..... County of.....  
 State of..... I hereby certify that the within instrument was filed in this office  
 for record on the..... day of....., 19.....  
 ..... by .....  
 (COUNTY OFFICIAL) (DEPUTY)

Form R6-7100-5/ (9/71)

☆ GPO—798-276

FILED Jan 21 1981  
 7-46-79