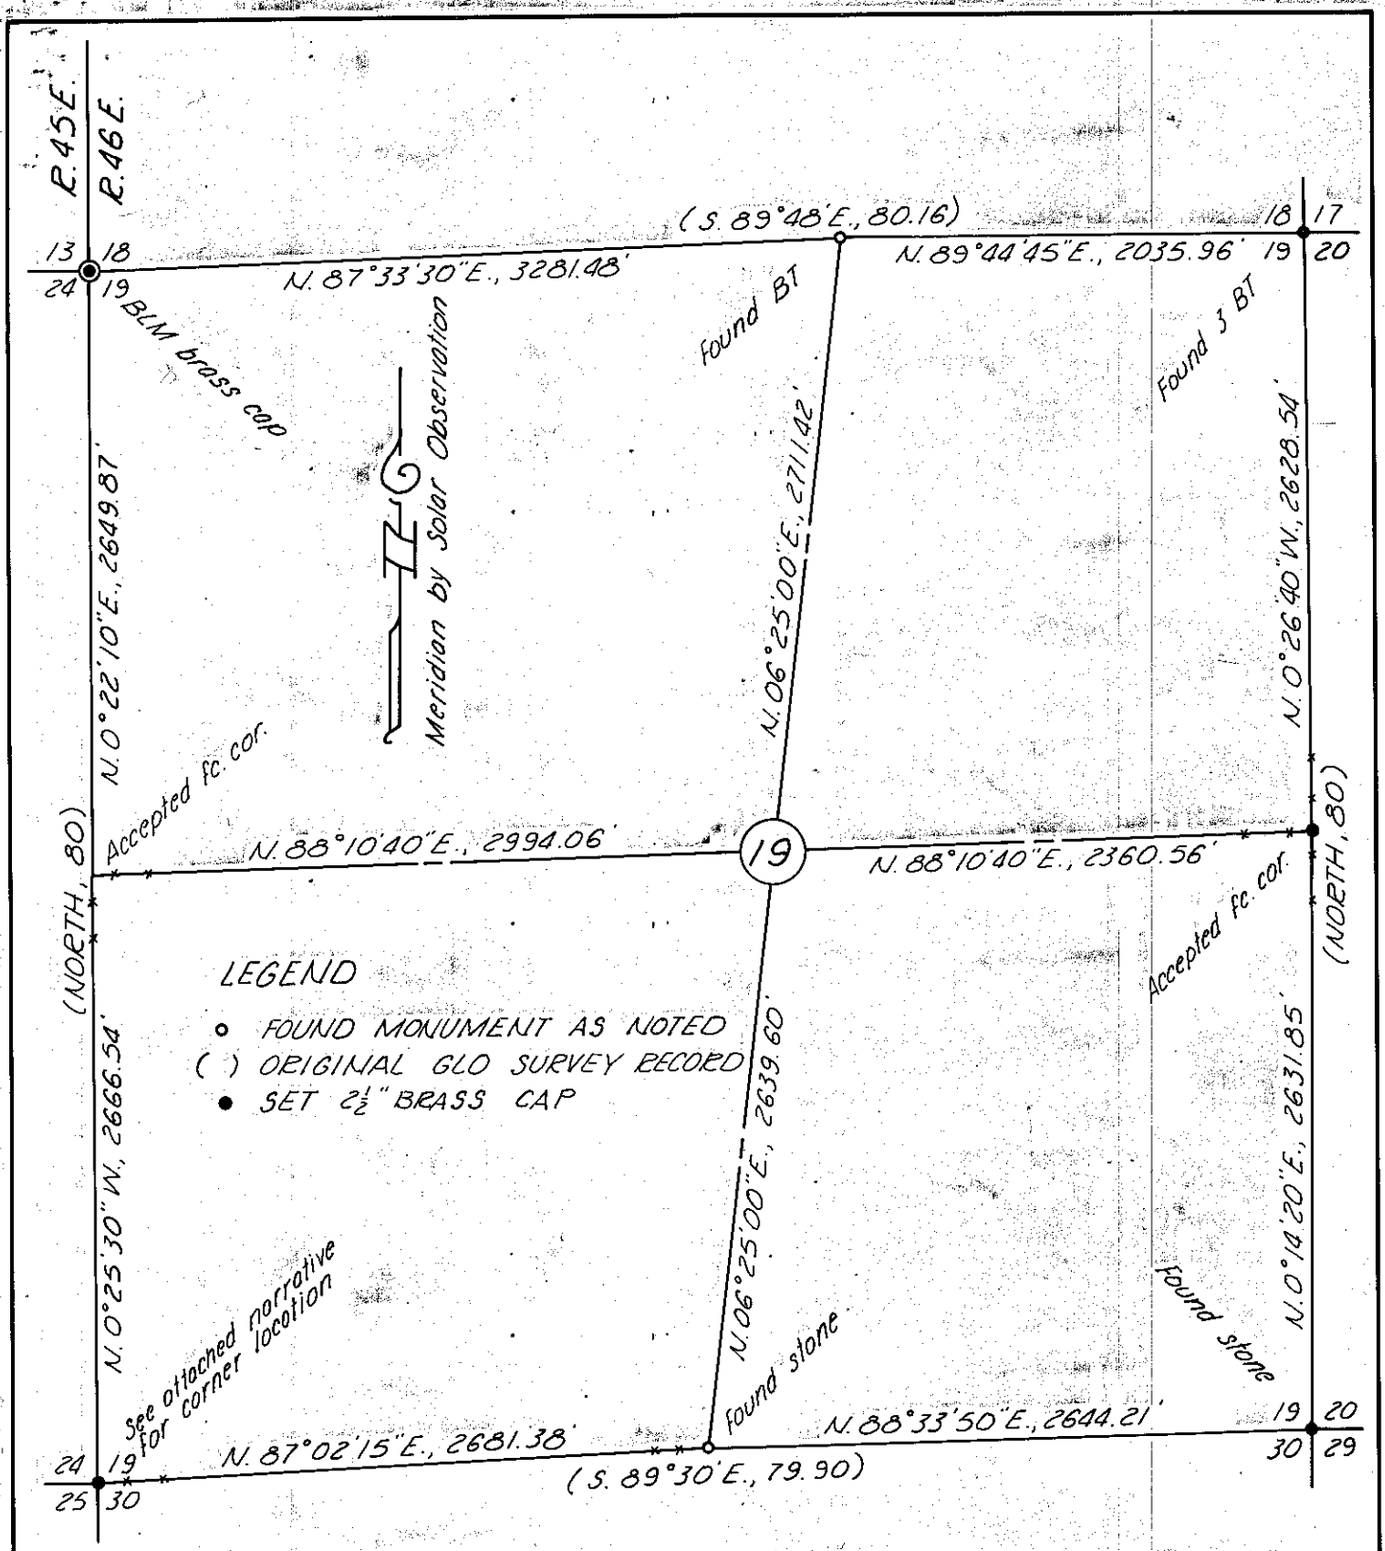

NARRATIVE BY ATTACHMENT

MAP OF SURVEY

SUBDIVISION OF SECTION 19, T. 7S., R. 46 E., W.M.

Surveyed Sept., 1977 & Feb., 1978 1"=800'

REGISTERED PROFESSIONAL LAND SURVEYOR

James D. Hanley

OREGON
SEPTEMBER 23, 1977
JAMES D. HANLEY
1206

FILED Jan. 26, 1981

BAKER COUNTY SURVEYOR

SURVEY NO. 7-46-80