


CERTIFIED RECORD OF LAND CORNER MONUMENTATION

History of original corner establishment:

Corner established by W. B. Barr under GLO contract no. 443 dated May 29, 1882.

Surveyor's General records state:

Set volcanic rock 15 x 9 x 6 ins 10 ins in the ground for 1/4 sec corner marked 1/4 on the west side and raised mound of rock alongside; pits impracticable

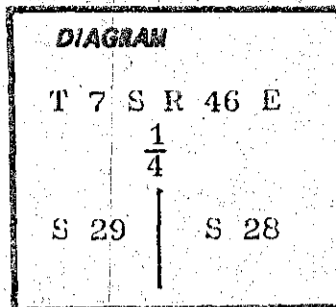


Description of corner evidence found:

Found a stone 15 x 10 x 5 inches marked 1/4 with a mound of stone alongside.

Description of monument and accessories I established to perpetuate the original location of this corner:

Set a 2 1/2 inch brass cap on a 1 inch iron pipe 31 inches long and projecting 5 inches out of the ground with a surrounding rock mound. Buried original stone alongside pipe.

Brass cap marked thus:

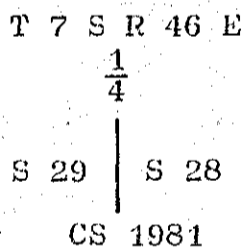

I hereby certify that the above described corner monument was properly monumented on Jan. 21, 1981, under my supervision and witnessed by Brad Gordon, Tom Fisk and Jim DeMastus.

REGISTERED  
PROFESSIONAL  
LAND SURVEYOR

*James D. Hanley*  
OREGON  
SEPTEMBER 23, 1977  
JAMES D. HANLEY  
1206

Office of..... County of.....  
State of....., I hereby certify that the within instrument was filed in this office  
for record on the..... day of....., 19.....  
..... by .....

(COUNTY OFFICIAL)

(DEPUTY)

Form R6-7100-51 (9/71)

FILED Jan 27, 1981  
BAKER COUNTY SURVEYOR  
SURVEY NO. 7-46-83

☆ GPO-798-276