

CERTIFIED RECORD OF LAND CORNER MONUMENTATION




History of original corner establishment:

Corner established by W. B. Barr under GLO contract no 443 dated May 29, 1882.

Surveyor's General records state:

Set iron stone 13 x 8 x 6 ins 9 ins in ground for 1/4 sec cor marked 1/4 on the west side, from which

A pine 5 ins diam bears N 41° E 40 lks dist marked 1/4 S BT
A pine 3 ins diam bears S 42° W 47 lks dist marked 1/4 S BT

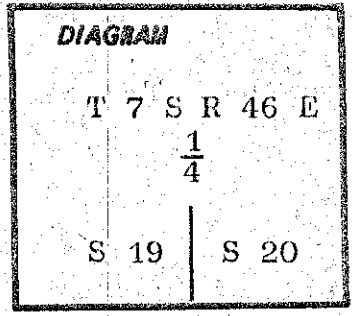

Description of corner evidence found:

Original corner and accessories not found. Accepted dated fence corner as corner location.

Description of monument and accessories established to perpetuate the original location of this corner:

Set a 2 1/2 inch brass cap on a 1 inch iron pipe 31 inches long and projecting 4 inches out of the ground with a surrounding rock mound.

Brass cap marked thus: T 7 S R 46 E
 $\frac{1}{4}$
 S 19 | S 20
 CS 1979

I hereby certify that the above described monument was properly established on Sept. 17, 1979, under my supervision and witnessed by Brad Gordon and Tom Fisk.

REGISTERED
PROFESSIONAL
LAND SURVEYOR

James D. Hanley

OREGON
SEPTEMBER 23, 1977
JAMES D. HANLEY
1206

Office of..... County of.....
 State of....., I hereby certify that the within instrument was filed in this office
 for record on the..... day of....., 19.....
 by
 (COUNTY OFFICIAL) (DEPUTY)

Form R6-7100-51 (9/71)

FILED Feb 5, 1981
 BAKER COUNTY SURVEYOR
 SURVEY NO. 7-46-84