


CERTIFIED RECORD OF LAND CORNER MONUMENTATION

History of original corner establishment:

Corner established by W. B. Barr under GLO contract no. 443 dated May 29, 1882.

Surveyor's General records state:

Set basalt rock 18 x 16 x 8 ins 12 ins in the ground for corner to Sec 17, 18, 19 and 20 marked with 3 notches on the south and 5 notches on the east edges from which:

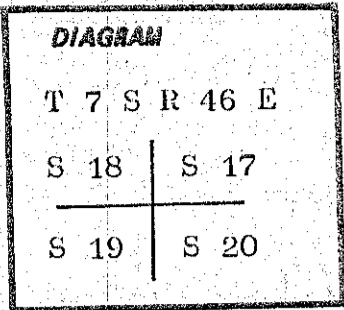

- A pine 46 ins diam bears N 04° E 163 lks dist marked T 7 S R 46 E S 17 BT
- A pine 11 ins diam bears N 67° W 110 lks dist marked T 7 S R 46 E S 18 BT
- A pine 20 ins diam bears S 32° W 80 lks dist marked T 7 S R 46 E S 19 BT

Description of corner evidence found:

A tree with approximately 4 inches overgrowth with the following scribes visible: S 46 17 (for T 7 S R 46 E S 17 BT) for Section 17 bearing tree.

A tree with healed blaze at proper location for Section 18 bearing tree. (the numbers 46 scribed on south face on open blaze, origin unknown)

A rotted stump for Section 19 bearing tree.

Description of monument and accessories established to perpetuate the original location of this corner:

Set a 2½ inch brass cap on a 1 inch iron pipe 31 inches long and projecting 5 inches out of the ground with a surrounding rock mound.

Brass cap marked thus:

T 7 S R 46 E	
S 18	S 17
S 19	S 20
CS 1979	

I hereby certify that the above described monument was properly established on Sept. 17, 1979, under my supervision and witnessed by Brad Gordon and Tom Fisk.

REGISTERED  
PROFESSIONAL  
LAND SURVEYOR

*James D. Hanley*

OREGON  
SEPTEMBER 23, 1977  
JAMES D. HANLEY  
1206

Office of..... County of.....  
 State of....., I hereby certify that the within instrument was filed in this office  
 for record on the..... day of....., 19.....  
 ..... by .....  
 (COUNTY OFFICIAL) (DEPUTY)

Form R6-7100-5/ (9/71)

FILED Feb. 5, 1981  
 BAKER COUNTY SURVEYOR  
 SURVEY NO. 7-46-85