

CERTIFIED RECORD OF LAND CORNER MONUMENTATION


N-5

History of original corner establishment:

Corner was established in 1882 by W. B. Barr, Deputy Surveyor under contract No. 443. Surveyor General's records state: Set basalt rock 18" x 16" x 8", 12" in ground for corner to Sec. 17, 18, 19, 20, marked with 3 notches on the South and 5 notches on the East edges from which:

- A Pine 46" dia. bears N 4 E, 163 lks. dist. marked T 7 S R 46 E S 17 BT.
- A Pine 11" dia. bears N 67 W, 110 lks. dist. marked T 7 S R 46 E S 18 BT.
- A Pine 20" dia. bears S 32 W, 80 lks. dist. marked T 7 S R 46 E S 19 BT.

No other trees within limits. Raised mound of rock alongside; pits impracticable.

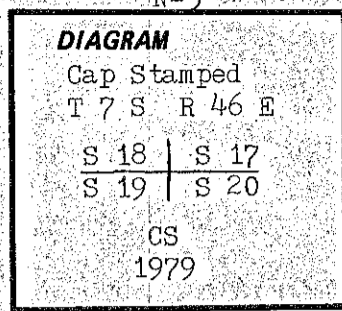

Description of corner evidence found:

At the Sec. Cor. location I found a 2 1/2" brass cap on a 1" iron pipe 8" above the ground set by County Surveyor in 1979. I found the two existing original bearing trees.

- A Pine approx. 52" dia. bears N 04 E, 163 lks. with a portion of the scribing visible.
- A Pine approx. 30" dia. bears N 67 W, 110 lks. with the face healed over.

Description of monument and accessories I established to perpetuate the original location of this corner:

At the Sec. Cor. location I set two new bearing trees as follows:

- A Pine 8" dia. bears S 27 15 E, 216.40' horiz. dist. scribed T 7 S R 46 E S 20 BT.
- A Pine 13" dia. bears S 11 30 W, 256.90' horiz. dist. scribed T 7 S R 46 E S 19 BT.

I hereby certify the above corner monument was re-established as herein described during May 1981,

Witnesses:

Mike Cain
Mike Cain (Inst. Man)
Mark L. Cain
Mark Cain (Chairman)

REGISTERED
PROFESSIONAL
LAND SURVEYOR

James H. Hambleton

OREGON
JULY 10, 1964
JAMES H. HAMBLETON
645

Office of..... County of.....
State of..... I hereby certify that the within instrument was filed in this office
for record on the..... day of....., 19.....
..... by

(COUNTY OFFICIAL)

(DEPUTY)

Form R6-7100-57 (9/71)

FILED July 2 1981
BAKER COUNTY SURVEYOR
SURVEY NO. 7-46-88