


CERTIFIED RECORD OF LAND CORNER MONUMENTATION

0-5

History of original corner establishment:
No previous history.

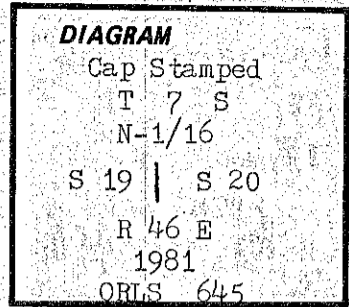

Description of corner evidence found:
None

Description of monument and accessories I established to perpetuate the original location of this corner:

At the 1/16 corner location I set a 2½" brass cap on a 30" galv. iron pipe, 4" above the surface of the ground, from which I set one bearing tree in Section 20, A Pine 9" dia. bears S 74 30 E, 68.90' horiz. dist. and scribed^N 1/16S S 20 BT. In Section 19 I used a tree as a reference but due to a hostile land owner I did not mark the tree, said tree is a Pine 6" dia. and bears S 19 45 W, 50.17' horiz. dist. with no marks on the tree. There are no other trees available in Section 19.

I hereby certify the above corner monument was established as herein described during June 1981.

Witnesses: Mike Cain
Mike Cain, Inst. Man
Mark R. Cain
Mark Cain, Chairman

REGISTERED
PROFESSIONAL
LAND SURVEYOR

James H. Hambleton

OREGON
JULY 1, 1984
JAMES H. HAMBLETON
645

Office of..... County of.....
State of....., I hereby certify that the within instrument was filed in this office
for record on the..... day of....., 19.....
..... by

(COUNTY OFFICIAL)

(DEPUTY)