


CERTIFIED RECORD OF LAND CORNER MONUMENTATION

P-3

History of original corner establishment:
No previous history.

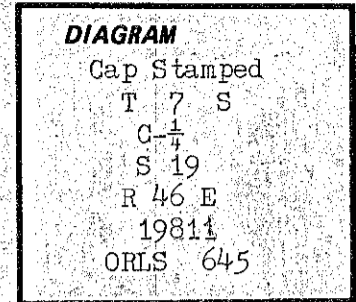

Description of corner evidence found:
None

Description of monument and accessories I established to perpetuate the original location of this corner:


At the $\frac{1}{4}$ corner location I set a 2 $\frac{1}{2}$ " brass cap on a 30" galv. iron pipe, 2" above the surface of the ground from which I set two bearing trees:

A Pine 7" dia. bears N 09 45 W, 5.0' horiz. dist. and scribed C $\frac{1}{4}$ S 19 BT.

A Pine 9" dia. bears S 28 30 W, 28.30' horiz. dist. and scribed C $\frac{1}{4}$ S 19 BT.

I hereby certify the above corner monument was established as herein described during June 1981.

REGISTERED
PROFESSIONAL
LAND SURVEYOR

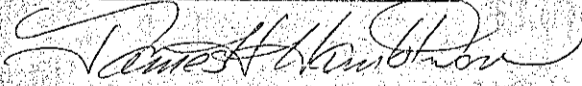

OREGON
JULY 10, 1954
JAMES H. HAMBLETON
645

Witnesses: Mike Cain
Mike Cain, Inst. Man
Mark R. Cain
Mark Cain, Chairman

Office of..... County of.....
State of..... I hereby certify that the within instrument was filed in this office
for record on the..... day of....., 19.....
..... by

(COUNTY OFFICIAL)

(DEPUTY)