


CERTIFIED RECORD OF LAND CORNER MONUMENTATION

R-3

History of original corner establishment:

Corner was established in 1882 by W. B. Barr, Deputy Surveyor under contract No. 443. Surveyor General's records state: Set basalt rock 14" x 11" x 9", 10" in ground for 1/4 Sec. corner marked 1/4 on the North side and raised mound of rock alongside; pits impracticable.

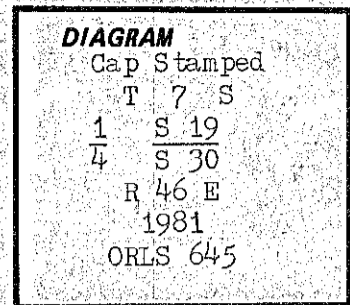

Description of corner evidence found:

At the assumed 1/4 corner location I found a basalt stone 14" x 9" x 8" with 1/4 marked on the northerly face. Stone was located at corner post of an ancient fence junction. Old fences running North-South, East and West. Stone appears as was described in the GLO notes.

Description of monument and accessories I established to perpetuate the original location of this corner:

At the 1/4 corner location I then set a 2 1/2" brass cap on a 30" galv. iron pipe, 6" above the surface of the ground. I buried the stone on the west side of the pipe, upside down with the 1/4 marks facing the monument.

There are no suitable bearing trees available as corner falls in private property.

I hereby certify the above corner monument was re-established as herein described during June 1981.

Witnesses:

Mike Cain
Mike Cain, Inst. Man

Mark R Cain
Mark Cain, Chainman

REGISTERED
PROFESSIONAL
LAND SURVEYOR

James H. Hambleton

OREGON
JULY 10, 1954
JAMES H. HAMBLETON
645

Office of..... County of.....

State of..... I hereby certify that the within instrument was filed in this office

for record on the..... day of....., 19.....

(COUNTY OFFICIAL)

(DEPUTY)