


CERTIFIED RECORD OF LAND CORNER MONUMENTATION

R-5

History of original corner establishment:

Corner was established in 1882 by W. B. Barr, Deputy Surveyor under contract No. 443. Surveyor General's records state: Set basalt-boulder 15" x 12" x 5", 10" in the ground for corner to Sec. 19, 20, 29, 30, marked with 2 notches on the South and 5 notches on the East-edges from which:

- A Pine 6" dia. bears N 9 E, 95 lks. dis. marked T 7 S R 46 E S 20 BT.
- A Pine 7" dia. bears N 89 W, 265 lks. dis. marked T 7 S R 46 E S 19 BT.
- A Pine 16" dia. bears S 59 W, 187 lks. dis. marked T 7 S R 46 E S 30 BT.
- A Pine 5" dia. bears S 55 E, 180 lks. dis. marked T 7 S R 46 E S 29 BT.

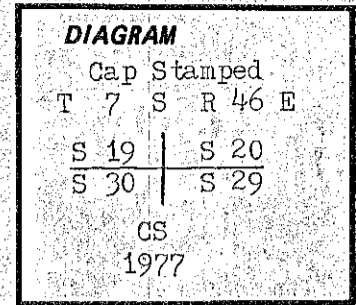

Description of corner evidence found:

At the assumed corner location I found the original stone as described in GLO notes in 1977. I now find a brass cap set later by County Surveyor in 1977, and being stamped as shown above, though he set no bearing trees. The stone is buried alongside the monument.

Description of monument and accessories I established to perpetuate the original location of this corner:

At the corner location I set 4 new bearing trees as follows:

- A Pine 11" dia. bears N 32 45 W, 51.20' horiz. dis. and scribed T 7 S R 46 E S 19 BT.
- A Pine 10" dia. bears S 82 30 W, 15.58' horiz. dis. and scribed T 7 S R 46 E S 30 BT.
- A Pine 10" dia. bears N 43 30 E, 14.10' horiz. dis. and scribed T 7 S R 46 E S 20 BT.
- A Pine 13" dia. bears S 72 15 E, 74.50' horiz. dis. and scribed T 7 S R 46 E S 29 BT.

I hereby certify the above corner monument was re-established as herein described during June 1981.

Witnesses:

Mike Cain
Mike Cain, Inst. Man

Mark Cain
Mark Cain, Chainman

REGISTERED
PROFESSIONAL
LAND SURVEYOR

James H. Hambleton

OREGON
JULY 10, 1964
JAMES H. HAMBLETON
645

Office of..... County of.....
State of..... I hereby certify that the within instrument was filed in this office
for record on the..... day of....., 19.....
..... by

(COUNTY OFFICIAL)

(DEPUTY)

Form R6-7100-57 (9/71)

FILED July 2, 1981
BAKER COUNTY SURVEYOR
SURVEY NO. 7-46-94