


REPORT  
 CORNER SEARCH, EVALUATION, MONUMENTING  
 and  
 BOUNDARY MARKING


From August To November, 1981

Region 6 Forest Wallowa-Whitman

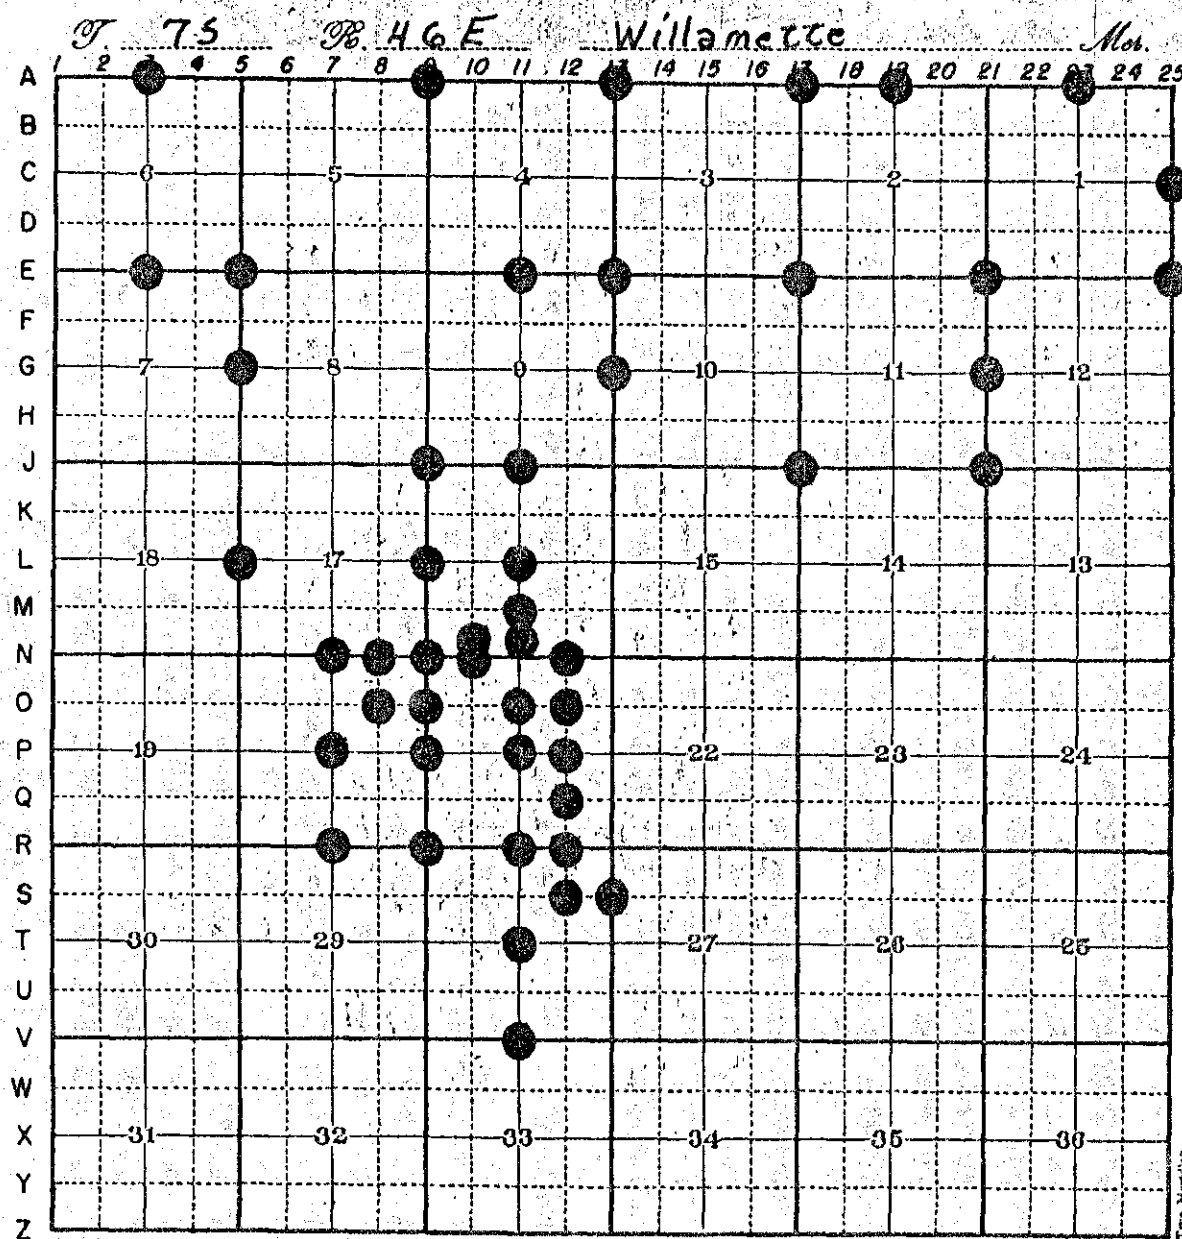

LEGEND

- |   |                              |     |                                       |
|---|------------------------------|-----|---------------------------------------|
| ○ | Corners searched for         | ●   | Corners monumented                    |
| ⊗ | Evidence believed acceptable | —●— | Boundary posted<br>(line only in red) |

FILED Jan. 25, 1982

BAKER COUNTY SURVEYOR

SURVEY NO. 7-46-96

GPO 887-198

7100-53