


CERTIFIED RECORD OF LAND CORNER MONUMENTATION

Index File No. A-13

History of original corner establishment:

Corner was originally established under G.L.O. contract No. 443 by W. B. Barr, during July of 1882. Surveyors General's notes state: "Set stake 4 ft. long 4 in. diam. 24 inches in ground for corner to sec. 3, 4, 33, 34, marked T7SR46E S34 on SW face and T6SR46E S33 on the NW face, T7SR46E S4 on the SW face and T7SR46E S3 on the SE face with 3 notches on the East and West edges, from which: a pine 48 in. diam. bears N69°E, 92 lks. dist. marked T6SR46E S34 BT. A fir 12 in. diam. bears N73°W, 79 lks. dist. marked T6SR46E S33 BT. A fir 24 in. diam. bears S68°W, 49 lks. dist. marked T7SR46E S4 BT. A fir 6 in. diam. bears S55°E, 134 lks. dist. marked T7SR46E S3 BT."

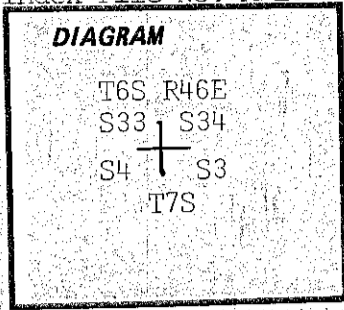

Description of corner evidence found:

Found no trace of record post. Found 15 ft. pine snag with full scribe. Measured S69°W, 60.9 ft. from face. From here measured S68°W, 33 ft. to very rotten down tree. No trace of SE and NW BTs.

Description of monument and accessories I established to perpetuate the original location of this corner:

At measured point set 2 1/2" x 30" galvanized pipe and brass cap marked:
 Set pipe 26" in the ground.
 From which by magnetic declination of N20°E:
 A 12" pine bears N78°E, 61.8 ft. scribed T6SR46E S34 BT.
 A 16" pine bears S52°E, 26.6 ft. scribed T7SR46E S3 BT.
 A 20" pine bears S43°W, 29.2 ft. scribed T7SR46E S4 BT.
 A 16" fir bears N62°W, 54.6 ft. scribed T6SR46E S33 BT.
 Painted blazes red and 6" red band around. Placed 54-3s, 54-4s, and brass washers stamped PLS 1051 on BTs. Placed 54-4 on a steel fence post 5' South of the corner.

T6S R46E
 S33 | S34
 S4 | S3
 T7S
 OR PLS 1051
 1981

**REGISTERED
 PROFESSIONAL
 LAND SURVEYOR**

Barry B. Barbour

OREGON
 OCT. 17, 1975
BARRY B. BARBOUR
 1051

I hereby certify that the above corner monument was reestablished as herein described.

Witnesses: Daniel Rowland
 Dave Poe

October 16, 1981

Office of.....County..Surveyor..... County of.....Baker.....
 State of.....Oregon....., I hereby certify that the within instrument was filed in this office
 for record on the...25... day of.....January....., 19...82
County...Surveyor..... byTom Henley.....
 (COUNTY OFFICIAL) (DEPUTY)