


**CERTIFIED RECORD OF LAND CORNER MONUMENTATION**

Index File No. A-17

**History of original corner establishment:**

Corner was originally established under G.L.O. contract No. 443 by W. B. Barr, during July of 1882. Surveyors General's notes state: "Set iron rock 14 x 10 x 10 ins. 10 inches in ground for corner to sec. 2, 3, 34, 35. Marked with 2 notches on the East and 4 notches on the West edges, from which: a fir 20 in. diam. bears N46°E, 94 lks. dist. marked T6SR46E S35 BT. A fir 6 in. diam. bears N45°W, 60 lks. dist. marked T6SR46E S34 BT. A fir 10 in. diam. bears S7°W, 47 lks. dist. marked T7SR46E S3 BT. A tamarack 22 in. diam. bears S86°E, 58 lks. dist. marked T7SR46E S2 BT."

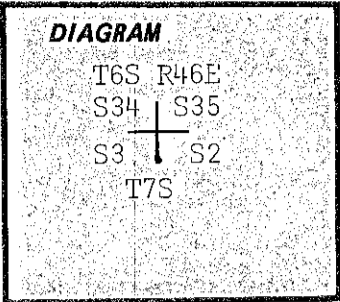


**Description of corner evidence found:**

Original corner position falls under 4' of road fill. Found rotten pine stump with grown over part of lower blaze and reverse BT. Measured N7°E, 31.0 ft. Found 36" pine stump with scribed T bearing S85°E, 38.0 ft. Note: NE and NW BTs fall in road.

**Description of monument and accessories I established to perpetuate the original location of this corner:**

At measured point set 2 1/2" x 30" galvanized pipe and brass cap marked:  
Set pipe 25" in the ground and mound of stone around to cap. From which by magnetic declination of N20°E:  
An 18" pine bears N39°E, 84.4 ft. scribed T6SR46E S35 BT.  
A 12" pine bears S11°E, 22.7 ft. scribed T7SR46E S2 BT.  
An 11" fir bears S04°W, 22.7 ft. scribed T7SR46E S3 BT.  
A 12" pine bears N12°W, 45.0 ft. scribed T6SR46E S34 BT.  
Painted blazes red and 6" red bands around. Placed 54-3s, 54-4s, and brass washers stamped PLS 1051 on BTs. Placed 54-4 on a steel fence post 5' North of the corner.

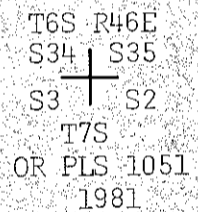

I hereby certify that the above corner monument was reestablished as herein described.

Witnesses: Daniel Rowland  
Dave Poe

October 16, 1981

REGISTERED  
PROFESSIONAL  
LAND SURVEYOR

*Barry B. Barbour*  
OREGON  
OCT. 17, 1975  
BARRY B. BARBOUR  
1031

Office of... County Surveyor... County of... Baker  
State of... Oregon... I hereby certify that the within instrument was filed in this office  
for record on the... 7<sup>th</sup> day of... January... 1982  
... County Surveyor... by... Tom Harley...  
(COUNTY OFFICIAL) (DEPUTY)