

CERTIFIED RECORD OF LAND CORNER MONUMENTATION

Index File No. A-23

**DIAGRAM**

T6S R46E  
S36  
1/4 —  
S1  
T7S

History of original corner establishment:

Corner was originally established under G.L.O. contract No. 443 by W. B. Barr, during July of 1882. Surveyors General's notes state: "Set basalt rock 12 x 10 x 10 ins. 8 inches in ground for 1/4 sec. corner marked 1/4 on the North side, from which: A pine 10 in. diam. bears S20°E, 120 lks. dist. marked 1/4 S. BT. A pine 10 in. diam. bears N55°E, 100 lks. dist. marked 1/4 S. BT."

Description of corner evidence found:

Found no trace of record stone. Found 30" pine with two grown over blazes. Measured S55°W, 66.0 ft. from face. From here a 30" pine stump with visible T bears S19°E, 79.5 ft.

Description of monument and accessories I established to perpetuate the original location of this corner:

At measured point set 2 1/2" x 30" galvanized pipe and brass cap marked:

Set pipe 22" in the ground and mound of stones around to cap. From which by magnetic declination of N20°E:

A 24" pine bears S30°E, 65.6 ft. scribed 1/4 S1 BT.


Painted blazes red and 6" red band around. Placed 54-3, 54-4, and brass washer stamped PLS 1051 on BT. Old BTs are signed. Placed 54-4 on a steel fence post 5' West of the corner.

T6S R46E  
S36  
1/4 —  
S1  
T7S  
OR PLS 1051  
1981

I hereby certify that the above corner monument was reestablished as herein described.

Witnesses: Daniel Rowland  
Dave Poe

October 20, 1981

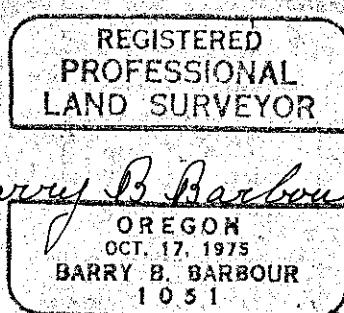

Office of...County...Surveyor..... County of...Baker.....

State of...Oregon..... I hereby certify that the within instrument was filed in this office for record on the 25 day of January, 1982.

County Surveyor by Tom Hanley  
(COUNTY OFFICIAL) (DEPUTY)

Form R6-7100-57 (9/71)

★ GPO - 798-276

FILED Jan. 25, 1982

BAKER COUNTY SURVEYOR

SURVEY NO. 7-46-102