


CERTIFIED RECORD OF LAND CORNER MONUMENTATION

Index File No. C-25

History of original corner establishment:

Corner was originally established under G.L.O. contract No. 443 by W. B. Barr, during July of 1882. Surveyors General's notes state: "Set basalt rock 15 x 12 x 10 ins. 10 inches in ground for 1/4 sec. corner marked 1/4 in the West side, from which: A fir 12 in. diam. bears S48°E, 115 lks. dist. marked 1/4 S. BT. A pine 26 in. diam. bears S34°W, 277 lks. dist. marked 1/4 S. BT."

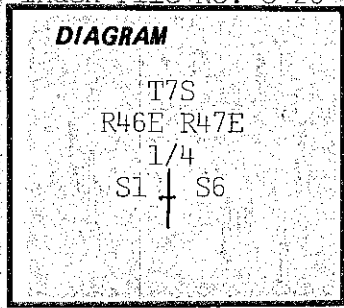


Description of corner evidence found:

Found no trace of record stone. Found down 24" fir with scribing 1/4 S. Measured N48°W, 75.9 ft. From here a 30" pine bears S35°W, 182.0 ft. with visible scribing.

Description of monument and accessories established to perpetuate the original location of this corner:

At measured point set 2 1/2" x 30" galvanized pipe and brass cap marked:
Set pipe 6" in the ground to bedrock and mound of stones around to cap.
From which by magnetic declination of N20°E:
A 24" pine bears N86°E, 64.1 ft. scribed 1/4 S6 BT.
Painted blazes red and 6" red band around. Placed 54-3, 54-4, and brass washer stamped PLS 1051 on BT.
Old BTs are signed. Placed 54-4 on a steel fence post 5' South of the corner.

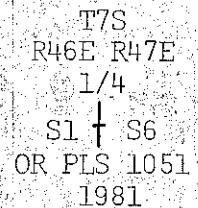

I hereby certify that the above corner monument was reestablished as herein described.

Witnesses: Daniel Rowland
Dave Poe

October 20, 1981

REGISTERED
PROFESSIONAL
LAND SURVEYOR

Barry B. Barbour

OREGON
OCT. 17, 1975
BARRY B. BARBOUR
1031

Office of.....County Surveyor..... County of.....Baker.....

State of.....Oregon..... I hereby certify that the within instrument was filed in this office

for record on the...75... day of.....January....., 1982.

.....*Tom Healey*..... by.....*Tom Healey*.....
(COUNTY OFFICIAL) (DEPUTY)