


CERTIFIED RECORD OF LAND CORNER MONUMENTATION

Index File No. E-3

History of original corner establishment:

Corner was originally established under G.L.O. contract No. 443 by W. B. Barr, during August of 1882. Surveyors General's notes state: "Set Granite rock 14 x 9 x 6 ins. 10 inches in ground for 1/4 Sec. corner, marked 1/4 on the North side, from which: A pine 24 in. diam. bears N52°W, 18 lks. dist. marked 1/4 S. BT. A pine 18 in. diam. bears S71°E, 40 lks. dist. marked 1/4 S. BT."

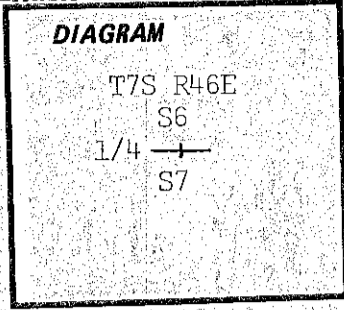

Description of corner evidence found:

Found 13 x 9 x 8 inch stone, clearly marked 1/4. From which: a 48" pine bears N49°W, 11.8 ft. with a partially opened blaze and visible scribing. A 45" pine stump bears S72°E, 26.6 ft. with BT scribing.

Description of monument and accessories established to perpetuate the original location of this corner:

At center of above stone set 2 1/2" x 30" galvanized pipe and brass cap marked:
Set pipe 24" in the ground and mound of stones around to cap. Placed marked stone alongside.
From which by magnetic declination of N20°E:
A 20" pine bears S65°W, 39.3 ft. scribed 1/4 S7 BT.
A 22" fir bears N89°W, 56.6 ft. scribed 1/4 S6 BT.
Painted blazes red and 6" red band around. Placed 54-3s, 54-4s, and brass washers stamped PLS 1051 on BTs. Placed 54-4 on a steel fence post 5' West of the corner.

T7S R46E
S6
1/4 —+—
S7
OR PLS 1051
1981

I hereby certify that the above corner monument was reestablished as herein described.

Witnesses: Daniel Rowland
Dave Poe

October 8, 1981

REGISTERED
PROFESSIONAL
LAND SURVEYOR

Barry B. Barbour

OREGON
OCT. 17, 1975
BARRY B. BARBOUR
1031

Office of..... County Surveyor..... County of..... Baker
State of... Oregon....., I hereby certify that the within instrument was filed in this office
for record on the... 25... day of... January....., 1982.
..... County Surveyor..... by..... Tom Hawley.....
(COUNTY OFFICIAL) (DEPUTY)

FILED Jan 25, 1982
BAKER COUNTY SURVEYOR
SURVEY NO. 7-46-104