


CERTIFIED RECORD OF LAND CORNER MONUMENTATION

Index File No. E-5

History of original corner establishment:

Corner was originally established under G.L.O. contract No. 443 by W. B. Barr, during August, 1882. Surveyors General's notes state. "Set granite rock 17 x 10 x 8 ins. 12 inches in ground for corner to Sec 5, 6, 7, 8, marked with 5 notches on the south and east edges, from which a fir 15 ins diam bears N40°E., 43 lks dist marked T7SR46ES5 BT. A pine 10 ins. diam bears N05°W., 100 lks dist marked T7SR46ES5 BT. A pine 24" in diam bears S12°W., 85 lks dist marked T7SR46ES7 BT. A pine 14 ins. diam bears S37°E., 38 lks dist. marked., T7SR46ES8 BT."

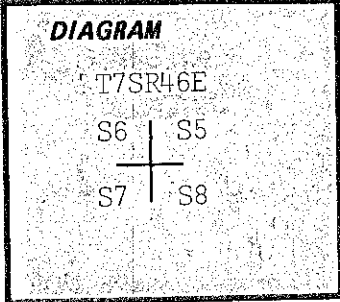


Description of corner evidence found:

Found loosely set 16 x 9 x 7 inch stone. Found 3 dim notches on 1 side. From which a 32" Fir bears N46°E., 27.9 ft. with grown over blaze. A 38" Pine bears S35°E., 24.7 ft. with partially open blaze. A 40" Pine stump bears S13°W., 54.8 ft. with open blaze and visible scribing. An old rotten log bears about N05°W., 66 ft.

Description of monument and accessories established to perpetuate the original location of this corner:

At center of above stone set 2 1/2" x 30" galvanized pipe and brass cap marked: Set pipe 25" in the ground and mound of stone around to cap. Placed marked stone alongside.

From which by magnetic declination of N20°E:
 A 10" Fir bears S30°W., 10.7 ft. scribed T7SR46E S7 BT.
 A 11" Pine bears N45°W., 28.0 ft. scribed T7SR46E S6 BT.
 Painted blazes red and 6" red band around. Placed 54-3s, 54-4s and brass washers stamped PLS 1051 on BTs. Placed 54-4 on a steel fence post 5' west of the corner.

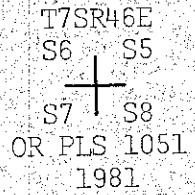

I hereby certify that the above corner monument was reestablished as herein described.

Witnesses: Daniel Rowland
 Troy Phillips

August 13, 1981

**REGISTERED
 PROFESSIONAL
 LAND SURVEYOR**

Barry B. Barbour

OREGON
 OCT. 17, 1975
BARRY B. BARBOUR
 1051

Office of..... County Surveyor..... County of..... Baker
 State of..... Oregon..... I hereby certify that the within instrument was filed in this office
 for record on the... 25... day of..... January....., 1982.
 County Surveyor..... by..... Tom Howley.....
 (COUNTY OFFICIAL) (DEPUTY)

FILED Jan 25, 1982
 BAKER COUNTY SURVEYOR
 SURVEY NO. 7-46-105