


CERTIFIED RECORD OF LAND CORNER MONUMENTATION

Index File No. E-11

History of original corner establishment:

Corner was originally established under G.L.O. contract No. 443 by W. B. Barr, during August, 1882. Surveyors General's notes state. "Set post 4 ft. long 4 ins. diam. 2 ft. in ground for 1/4 Sec. corner marked 1/4S on the North side from which, A pine 34 ins. diam. bears S69°W., 34 lks. dist. marked 1/4S BT. a pine 36 ins. diam. bears N76°E., 20 lks. dist. marked 1/4S BT."

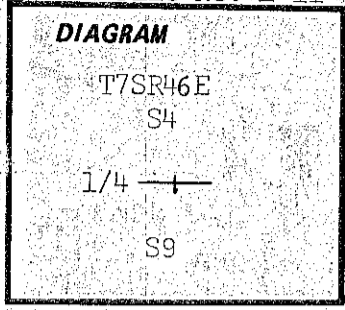

Description of corner evidence found:

Found no trace of record post. Found 36" pine stump with visible BT. Measured S76°W., 14.5 ft. From here a burnt stump bears S47°W., 24.0 ft.

Description of monument and accessories established to perpetuate the original location of this corner:

At measured point set 2 1/2" x 30" galvanized pipe and brass cap marked: Set pipe 25" in the ground. No rock in the area. From which by magnetic declination of N20°E:
A 16" pine bears S55°E., 47.7 ft. scribed 1/4S9 BT.
A 14" fir bears N04°W., 53.6 ft. scribed 1/4S4 BT.
Painted blazes red and 6" red band around. Placed 54-3s, 54-4s and brass washers stamped PLS 1051 on The BT. Placed 54-4 on a steel fence post 5' east of the corner.

T7SR46E
S4
1/4 ———→
S9
OR PLS 1051
1981

I hereby certify that the above corner monument was reestablished as herein described.

Witnesses: Daniel Rowland
Troy Phillips

August 13, 1981

REGISTERED
PROFESSIONAL
LAND SURVEYOR

Barry B. Barbour
OREGON
OCT. 17, 1975
BARRY B. BARBOUR
1051

Office of... County Surveyor County of... Baker
State of... Oregon I hereby certify that the within instrument was filed in this office
for record on the... 25 day of... January 1982.
..... County Surveyor by *Tara Hanley*
(COUNTY OFFICIAL) (DEPUTY)

FILED Jan. 25, 1982
BAKER COUNTY SURVEYOR
SURVEY NO. 7-46-106