


**CERTIFIED RECORD OF LAND CORNER MONUMENTATION**

Index File No. E-13

**History of original corner establishment:**

Corner was originally established under G.L.O. contract No. 443 by W. B. Barr, during August of 1882. Surveyors General's notes state: "Set basalt rock 18 x 9 x 8 ins. 12 inches in ground for corner to Sec. 3, 4, 9, 10, marked with 5 notches on the South and 3 notches on the East edges from which: A pine 11 in. diam. bears N79°E, 102 lks. dist. marked T7SR46E S3 BT. A pine 17 in. diam. bears N8°W, 95 lks. dist. marked T7SR46E S4 BT. A pine 5 in. diam. bears S39°W, 150 lks. dist. marked T7SR46E S9 BT. A pine 9 in. diam. bears S85°E, 108 lks. dist. marked T7SR46E S10 BT."

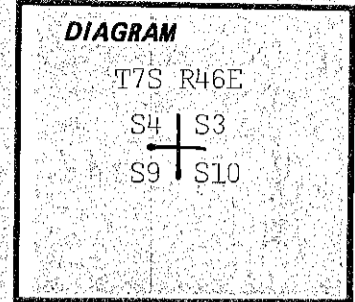

**Description of corner evidence found:**

Found no trace of record stone or South BTs. Found 40" pine with grown over blazes. Measured S8°E, 62.7 ft. From here 30" pine stump bears N80°E, 62.4 ft.

**Description of monument and accessories I established to perpetuate the original location of this corner:**

At measured point set 2 1/2" x 30" galvanized pipe and brass cap marked:  
Set pipe 14" in the ground and mound of stone around to cap. From which by magnetic declination of N20°E:  
A 16" pine bears N59°E, 92.3 ft. scribed T7SR46E S3 BT.  
A 30" pine bears S80°E, 89.0 ft. scribed T7SR46E S10 BT.  
A 20" pine bears S60°W, 102.6 ft. scribed T7SR46E S9 BT.  
Painted blazes red and 6" red band around. Placed 54-3s, 54-4s, and brass washers stamped PLS 1051 on BTs. Old BTs are signed. Placed 54-4 on a steel fence post 5' East of the corner.

T7S R46E  
S4 | S3  
S9 | S10  
OR PLS 1051  
1981

I hereby certify that the above corner monument was reestablished as herein described.

Witnesses: Daniel Rowland  
Dave Poe

October 20, 1981

REGISTERED  
PROFESSIONAL  
LAND SURVEYOR

*Barry B. Barbour*

OREGON  
OCT. 17, 1975  
BARRY B. BARBOUR  
1031

Office of..... County Surveyor..... County of..... Baker  
State of..... Oregon..... I hereby certify that the within instrument was filed in this office  
for record on the... 25... day of... January....., 19... 81  
..... County Surveyor..... by..... *T. H. Healy*.....  
(COUNTY OFFICIAL) (DEPUTY)