


CERTIFIED RECORD OF LAND CORNER MONUMENTATION

Index File No. E-21

History of original corner establishment:

Corner was originally established under G.L.O. contract No. 443 by W. B. Barr, during August of 1882. Surveyors General's notes state: "Set Lava rock 16 x 12 x 6 ins. 11 inches in ground for corner to Sec. 1, 2, 11, 12 marked with 5 notches on the South and 1 notch on the East edges from which: a pine 20 in. diam. bears N27°E., 75 lks. dist. marked T7SR46E1 BT. A pine 26 in. diam. bears N47°W., 22 lks. dist. marked T7SR46E2 BT. A pine 24 in. diam. bears S33°W., 22 lks. dist. marked T7SR46ES11 BT. A pine 12 in. diam. bears S23°E., 126 lks, dist, marked T7SR46ES12 BT."

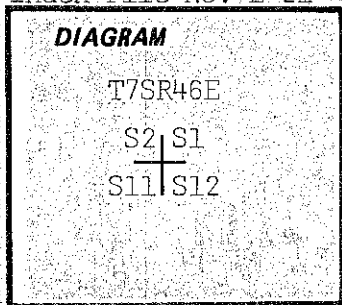

Description of corner evidence found:

Under down and rotten NW BT, found 15 x 12 x 5 inch stone without notches, from which: A 36" pine bears S33°W, 14.5 ft. and a 30" pine bears S22°E, 85.3 ft.

Description of monument and accessories established to perpetuate the original location of this corner:


At center of stone set 2 1/2" x 30" galvanized pipe and brass cap marked: Set pipe 24" in the ground and stone alongside. Mound of stone around to cap. From which by magnetic declination of N20°E:
 A 12" fir bears N86°E, 6.8 ft. scribed T7SR46E S1 BT,
 A 22" fir bears N76°W, 48.7 ft. scribed T7SR46E S2 BT.
 Painted blazes red and 6" red band around. Placed 54-3s, 54-4s and brass washers stamped PLS 1051 on BTs. Old BTs are signed. Placed 54-4 on a steel fence post 5' South of the corner.

T7SR46E
 S2 | S1
 S11 | S12
 OR PLS 1051
 1981

I hereby certify that the above corner monument was reestablished as herein described.

Witnesses: Daniel Rowland
 Dave Poe

October 21, 1981

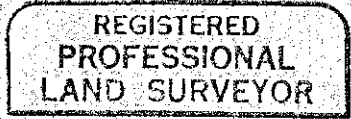

Barry B. Barbour
 OREGON
 OCT. 17, 1975
 BARRY B. BARBOUR
 1031

Office of..... County Surveyor..... County of..... Baker.....
 State of..... Oregon..... I hereby certify that the within instrument was filed in this office
 for record on the 25 day of..... January....., 1982
 *Tom Healy* by *Tom Healy*
 (COUNTY OFFICIAL) (DEPUTY)

FILED Jan 25, 1982
 BAKER COUNTY SURVEYOR
 SURVEY NO. 7-46-109