


**CERTIFIED RECORD OF LAND CORNER MONUMENTATION**

Index File No. G-5

**History of original corner establishment:**

Corner was originally established under G.L.O. contract No. 443 by W. B. Barr, during August of 1882. Surveyors General's notes state: "Set Granite boulder 14 x 8 x 6 ins. 10 inches in ground for 1/4 Sec. corner, marked 1/4 on the West side, from which: A pine 18 in. diam. bears S43°W, 22 lks. dist. marked 1/4 S. BT. A fir 38 in. diam. bears S63°E, 55 lks. dist. marked 1/4 S. BT."

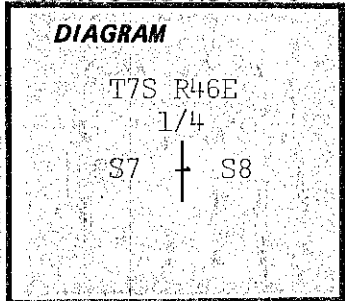

**Description of corner evidence found:**

Found 13 x 9 x 8 inch stone dimly marked 1/4, from which a 33" pine bears S44°W, 13.1 ft. and a rotten fir stump bears S63°E, 37.4 ft.

**Description of monument and accessories established to perpetuate the original location of this corner:**

At center of the above stone set 2 1/2" x 30" galvanized pipe and brass cap marked:  
Set pipe 24" in the ground and mound of stone around to cap.  
Placed marked stone alongside.  
From which by magnetic declination of N20°E:  
A 15" fir bears S70°E, 36.7 ft. scribed 1/4 S8 BT.  
Painted blazes red and 6" red band around. Placed 54-3, 54-4, and brass washer stamped PLS 1051 on BT. Old BT ringed and has signs.  
Placed 54-4 on a steel fence post 5' North of the corner.

T7S R46E  
1/4  
S7 + S8  
OR PLS 1051  
1981

I hereby certify that the above corner monument was reestablished as herein described.

Witnesses: Daniel Rowland  
Dave Poe

October 8, 1981

REGISTERED  
PROFESSIONAL  
LAND SURVEYOR

*Barry B. Barbour*

OREGON  
OCT. 17, 1975  
BARRY B. BARBOUR  
1051

Office of.....County Surveyor..... County of... Baker.....  
State of... Oregon..... I hereby certify that the within instrument was filed in this office  
for record on the... 7<sup>th</sup>... day of... January....., 1982.  
..... County Surveyor..... by ..... Tom Henley.....  
(COUNTY OFFICIAL) (DEPUTY)

FILED Jan 25, 1982  
BAKER COUNTY SURVEYOR  
SURVEY NO. 7-46-111