


CERTIFIED RECORD OF LAND CORNER MONUMENTATION

Index File No L-11

History of original corner establishment:

None

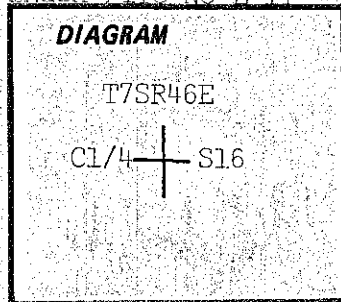

Description of corner evidence found:

None

Description of monument and accessories I established to perpetuate the original location of this corner:

At surveyed point set 2 1/2" x 30" galvanized pipe and brass cap marked: Set pipe 26" in the ground. No rock in the area. From which by magnetic declination of N20°E;
 A 20" pine bears N29°E., 30.0 ft. scribed CL/4S16 BT.
 A 20" pine bears S14°E., 13.3 ft. scribed CL/4S16 BT.
 Painted blazes red and 6" red band around. Placed 54-3s, 54-9s and brass washers stamped PLS 1051 on BT. Placed 54-9 on a steel fence post 5' west of the corner.

T7SR46E

CL/4 — S16

OR PLS 1051
1981

I hereby certify that the above corner monument was established as herein described.

Witnesses: Daniel Rowland
Dave Poe

September 9, 1981

REGISTERED
PROFESSIONAL
LAND SURVEYOR

Barry B. Barbour
 OREGON
 OCT. 17, 1975
 BARRY B. BARBOUR
 1031

Office of.....County Surveyor..... County of...Baker.....
 State of.....Oregon..... I hereby certify that the within instrument was filed in this office
 for record on the...25...day of...January... 1982
County Surveyor..... byTom Henley.....
 (COUNTY OFFICIAL) (DEPUTY)

FILED Jan. 25, 1982
 BAKER COUNTY SURVEYOR
 SURVEY NO. 7-46-117