


CERTIFIED RECORD OF LAND CORNER MONUMENTATION

Index File No. G-13

History of original corner establishment:

Corner was originally established under G.L.O. contract No. 443 by W. B. Barr, during August, 1882. Surveyor General's note state: "Set basalt rock 12 x 10 x 5 ins. 8 ins. in ground for 1/4 Sec. corner marked 1/4 on the West side from which, A pine 14 ins. diam. bears N61°W., 55 lks. dist. marked 1/4S BT. A pine 6 ins. dia. bears N64°E., 110 lks. dist. marked 1/4S BT."

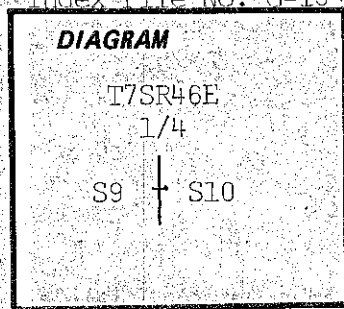

Description of corner evidence found:

Found no trace of record stone. Skidding in area. Found 28" pine, opened blaze visible 1/4. Measured S64°W., 72.6 ft. Found no trace of NW BT.

Description of monument and accessories I established to perpetuate the original location of this corner:

At measured point set 2 1/2" x 30" galvanized pipe and brass cap marked: Set pipe 18" in the ground and mound of stone around to cap. From which by magnetic declination of N20°E: A 12" pine bears N09°E., 54.0 ft. scribed 1/4S10 BT. A 18" pine bears N77°W., 29.5 ft. scribed 1/4S9 BT. Painted blazes red and 6" red band around. Placed 54-3s, 54-4s and brass washers stamped PLS 1051 on BT. Placed 54-4 on a steel fence post 5' south of the corner.

T7SR46E
1/4
S9 + S10
OR PLS 1051
1981

I hereby certify that the above corner monument was reestablished as herein described.

Witnesses: Daniel Rowland
Dave Poe

August 19, 1981

REGISTERED
PROFESSIONAL
LAND SURVEYOR

Barry B. Barbour

OREGON
OCT. 17, 1975
BARRY B. BARBOUR
1051

Office of County Surveyor..... County of Baker
State of Oregon..... I hereby certify that the within instrument was filed in this office
for record on the 25. day of January....., 1982.
County Surveyor..... by *Tom Henley*
(COUNTY OFFICIAL) (DEPUTY)

FILED Jan. 25, 1982
BAKER COUNTY SURVEYOR
SURVEY NO. 7-46-113