


CERTIFIED RECORD OF LAND CORNER MONUMENTATION

Index File No. J-9

History of original corner establishment:

Corner was originally established under G.L.O. contract No. 443 by W. B. Barr, during August, 1882. Surveyor General's notes state: "Set basalt rock 12 X 10 X 5 ins. 8 inches in ground for corner to Sec. 8, 9, 16, 17 on hillside facing East. Marked with 4 notches on the South and East edges, from which:
 A pine 12 in. diam. bears N77°E, 118 lks. dist. marked T7S R46E S9 BT. A pine 38 in. diam. bears N31°W, 47 lks. dist. marked T7S R46E S8 BT. A pine 10 in. diam. bears S69°W, 50 lks. dist. marked T7S R46E S17 BT. A pine 15 in. diam. bears S5°E, 110 lks. dist. marked T7S R46E S16 BT."

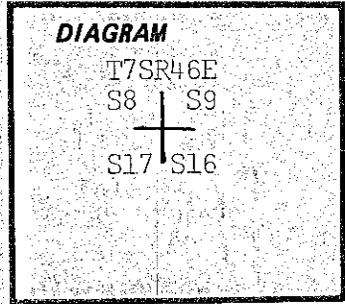

Description of corner evidence found:

Found no trace of record stone. Area was logged. Found 40" pine stump with visible BT. Measured S31°E., 31.0 ft. from where an old burnt and rotten stump bears N77°E., 77.8 ft. Found rotten stump S03°E., 72.7 ft. No trace of SW BT.

Description of monument and accessories I established to perpetuate the original location of this corner:

At measured point set 2 1/2" x 30" galvanized pipe and brass cap marked: Set pipe 24" in the ground.
 From which by magnetic declination of N20°E:
 A 15" fir bears N46°E., 33.0 ft. scribed T7SR46ES9 BT.
 A 12" fir bears S88°E., 32.7 ft. scribed T7SR46ES16 BT.
 A 10" fir bears S09°W., 42.4 ft. scribed T7SR46ES17BT.
 A 12" fir bears N34°W., 88.0 ft. scribed T7SR46ES8 BT.
 Painted blazes red and 6" red band around. Placed 54-3s, 54-4s and brass washers stamped PLS 1051 on the BT. Placed 54-4 on a steel fence post 5' south of the corner.



I hereby certify that the above corner monument was reestablished as herein described.

Witnesses: Daniel Rowland
 Troy Phillips

August 18, 1981

**REGISTERED
 PROFESSIONAL
 LAND SURVEYOR**

Barry B. Barbour
**OREGON
 OCT. 17, 1975
 BARRY B. BARBOUR
 1031**

Office of...County...Surveyor..... County of...Baker.....
 State of...Oregon..... I hereby certify that the within instrument was filed in this office
 for record on the...7...day of...January....., 19...82

.....County...Surveyor..... by*Tom Healey*.....
 (COUNTY OFFICIAL) (DEPUTY)

FILED Jan 25, 1982
 BAKER COUNTY SURVEYOR
 SURVEY NO. 7-46-115