


CERTIFIED RECORD OF LAND CORNER MONUMENTATION

Index File No. L-5

History of original corner establishment:

Corner was originally established under G.L.O. contract No. 443 by W. B. Barr, during August of 1882. Surveyors General's notes state: "Set basalt rock 16 x 12 x 10 ins. 11 inches in ground for 1/4 Sec. corner marked on the West side, from which: A fir 24 in. diam. bears S73°E, 7 lks. dist. marked 1/4 S. BT. A fir 30 in. diam. bears N70°W, 41 lks. dist. marked 1/4 S. BT."

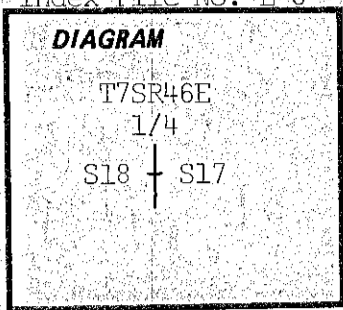

Description of corner evidence found:

Found no trace of record stone. Found 36" fir with grown over blazes. Measured N73°E, 4.6 ft. From here a rotten fir stump hole bears N69°W, 28.0 ft. Found backside BT on small part.

Description of monument and accessories established to perpetuate the original location of this corner:

At measured point set 2 1/2" x 30" galvanized pipe and brass cap marked:
Set pipe 24" in the ground and mound of stones around to cap.
From which by magnetic declination of N20°E:
A 26" pine bears N49°W, 46.0 ft. scribed 1/4 S18 BT.
Painted blazes red and 6" red band around. Placed 54-3, 54-4, and brass washer stamped PLS 1051 on BT. Old BT has been signed.

T7S R46E
1/4
S18 + S17
OR PLS 1051
1981

I hereby certify that the above corner monument was reestablished as herein described.

Witnesses: Daniel Rowland
Dave Poe

October 19, 1981

REGISTERED
PROFESSIONAL
LAND SURVEYOR

Barry B. Barbour

OREGON
OCT. 17, 1975
BARRY B. BARBOUR
1051

Office of..... County Surveyor..... County of..... Baker.....
State of..... Oregon..... I hereby certify that the within instrument was filed in this office
for record on the... 7.5... day of... January..... 19.82
..... County Surveyor..... by..... *Tom Hensley*.....
(COUNTY OFFICIAL) (DEPUTY)