


**CERTIFIED RECORD OF LAND CORNER MONUMENTATION**

Index File No. L-9

**History of original corner establishment:**

Corner was originally established under G.L.O. contract No. 443 by W. B. Barr, during August, 1882. Surveyors General's notes state: "Set basalt rock 12 x 9 x 6 ins. 8 in. in ground, for 1/4 Sec corner marked 1/4 on the west side from which a pine 10 ins. diam bears N17°W., 27 lks. dist. marked 1/4S BT. A pine 8 ins. diam. bears N45°E., 42 lks. dist. marked 1/4S BT."

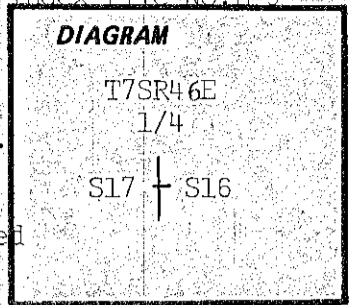

**Description of corner evidence found:**

Found no trace of record stone. Skid trails from past logging. Found two pines with blazes. Measured S17°E., 17.8 ft. from 16" pine with grown over blazes. N45°E., 27.5 ft. is a 14" pine with dim 1/4S scribe.

**Description of monument and accessories established to perpetuate the original location of this corner:**


At measured point set 2 1/2" x 30" galvanized pipe and brass cap marked: Set pipe 18" in the ground and mound of stone around to cap. From which by magnetic declination of N20°E: A 16" fir bears S24°W., 78.0 ft. scribed 1/4S17-BT. Painted blazes red and 6" red band around. Placed 54-3s, 54-4s and brass washers stamped PLS 1051 on the BT. Placed 54-4 on a steel fence post 5' south of the corner.

T7SR46E  
1/4  
S17 + S16  
OR PLS 1051  
1981

I hereby certify that the above corner monument was reestablished as herein described.

Witnesses: Daniel Rowland  
Dave Poe

August 18, 1981

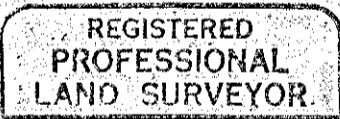

*Barry B. Barbour*  
OREGON  
OCT. 17, 1975  
BARRY B. BARBOUR  
1051

Office of County Surveyor ..... County of Baker  
Oregon  
State of ..... I hereby certify that the within instrument was filed in this office  
for record on the 7-5 day of January ..... , 1982  
County Surveyor ..... by Tamm Hendley  
(COUNTY OFFICIAL) (DEPUTY)

FILED Jan 25, 1982  
BAKER COUNTY SURVEYOR  
SURVEY NO. 7-46-120