


CERTIFIED RECORD OF LAND CORNER MONUMENTATION

Index File No. M-11

History of original corner establishment:

None

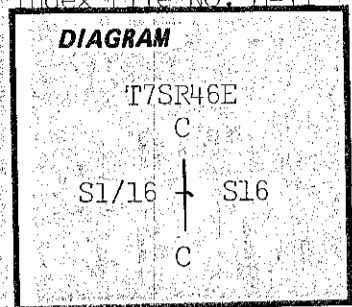


Description of corner evidence found:

None

Description of monument and accessories I established to perpetuate the original location of this corner:

At surveyed point set 2 1/2" x 30" galvanized pipe and brass cap marked: Set pipe 25" in the ground, From which by magnetic declination of N20°E:
 A 21" Pine bears N15°E., 28.6 ft. scribed CS1/16S16 BT.
 A 12" Pine bears S72°W., 49.4 ft. scribed CS1/16S16 BT.
 Painted blazes red and 6" red band around. Placed 54-3s, 54-9s and brass washers stamped PLS 1051 on the BT. Placed 54-2 and 54-9 on a steel fence post 5' east and 54-2 on a steel fence post 5' south of the corner.

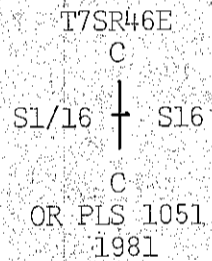

I hereby certify that the above corner monument was established as herein described.

Witnesses: Daniel Rowland
 Dave Poe

September 9, 1981

**REGISTERED
 PROFESSIONAL
 LAND SURVEYOR**

Barry B. Barbour

**OREGON
 OCT. 17, 1975
 BARRY B. BARBOUR
 1031**

Office of County Surveyor..... County of Baker.....
 State of Oregon..... I hereby certify that the within instrument was filed in this office
 for record on the 25 day of January..... 1982
 County Surveyor by *Tara Hanley*
 (COUNTY OFFICIAL) (DEPUTY)

Form R6-7100-57 (9/71)

☆ GPO—798-276

FILED Jan. 25, 1982
 BAKER COUNTY SURVEYOR
 SURVEY NO. 7-46-121