

CERTIFIED RECORD OF LAND CORNER MONUMENTATION

Index File No. N-7

History of original corner establishment:

Corner was originally established under G.L.O. contract No. 443 by W. B. Barr, during August of 1882. Surveyors General's notes state: "Set post 4 ft. long 4 in. diam. 2 ft. in ground for 1/4 Sec. corner marked 1/4 on the North side, from which: A fir 5 in. diam. bears S75°E, 35 lks. dist. marked 1/4 S. BT. A pine 5 in. diam. bears N70°W, 55 lks. dist. marked 1/4 S. BT."

DIAGRAM

T7S R46E
S17
1/4 —+—
S20

Description of corner evidence found:

Found no trace of record post or BTs. Opened up one large pine and one fir in two areas close to the corner.

Description of monument and accessories established to perpetuate the original location of this corner:


At surveyed point set 2 1/2" x 30" galvanized pipe and brass cap maked;
Set pipe 24" in the ground and mound of stone around to cap. From which by magnetic declination of N20°E;
A 15" pine bears N53°E, 24.0 ft. scribed 1/4 S17 BT.
A 14" pine bears S56°E, 29.4 ft. scribed 1/4 S20 BT.
Painted blazes red and 6" red band around. Placed 54-3s, 54-4s, and brass washers stamped PLS 1051 on BTs. Placed 54-4 on a steel fence post 5' East of corner.

T7S R46E
S17
1/4 —+—
S20
OR PLS 1051
1981


I hereby certify that the above corner monument was reestablished as herein described.

Witnesses: Daniel Rowland
Dave Poe

October 13, 1981

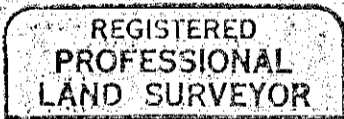

Barry B. Barbour

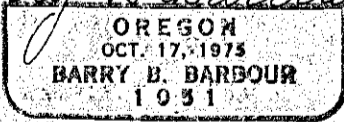

Office of.....County Surveyor.....County of.....Baker.....
State of.....Oregon..... I hereby certify that the within instrument was filed in this office
for record on the 25 day of January, 1982
.....County Surveyor..... by*Tom Healey*.....
(COUNTY OFFICIAL) (DEPUTY)

FILED *Jan 25, 1982*
BAKER COUNTY SURVEYOR
SURVEY NO: *7-46-124*