


CERTIFIED RECORD OF LAND CORNER MONUMENTATION

Index File No. N-8

History of original corner establishment:

No history.

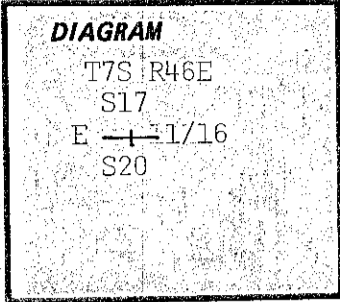

Description of corner evidence found:

None.

Description of monument and accessories I established to perpetuate the original location of this corner:


At surveyed point set 2 1/2" x 30" galvanized pipe and brass cap marked:
 Set pipe 26" in the ground.
 From which by magnetic declination of N20°E:
 A 14" pine bears N69°E, 30.5 ft. scribed E 1/16 S17 BT.
 A 16" pine bears S57°W, 50.5 ft. scribed E 1/16 S20 BT.
 Painted blazes red and 6" red band around. Placed 54-3s, 54-9s, and brass washers stamped PLS 1051 on BTs. Placed 54-2 and 54-9 on a steel fence post 5' East, and 54-2 on a steel fence post 5' South of the corner.

T7S R46E
 S17
 E — 1/16
 S20
 OR PLS 1051
 1981

I hereby certify that the above corner monument was established as herein described.

Witnesses: Daniel Rowland
 Dave Poe

October, 14, 1981

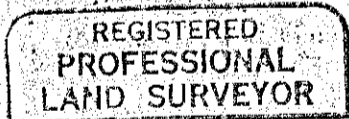

Barry B. Barbour
 OREGON
 OCT. 17, 1975
 BARRY B. BARBOUR
 1051

Office of.....County Surveyor.....County of...Baker.....
 State of.....Oregon....., I hereby certify that the within instrument was filed in this office
 for record on the...25...day of...January....., 1982...
 County Surveyor..... byTom Hawley.....
 (COUNTY OFFICIAL) (DEPUTY)

FILED Jan. 25, 1982
 BAKER COUNTY SURVEYOR
 SURVEY NO. 7-46-125