


CERTIFIED RECORD OF LAND CORNER MONUMENTATION

Index File No. N-10

History of original corner establishment:

None

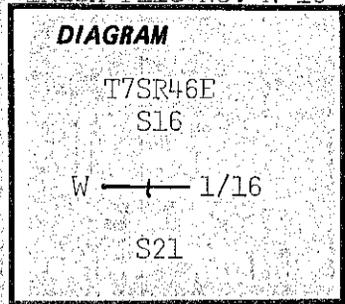

Description of corner evidence found:

None

Description of monument and accessories established to perpetuate the original location of this corner:

At surveyed point set 2 1/2" x 30" galvanized pipe and brass cap marked: Set pipe 25" in the ground. No rock in the area. From which by magnetic declination of N20°E:

A 14" pine bears S34°E., 21.8 ft. scribed W1/16S21 BT.

A 16" pine bears N08°E., 79.7 ft. scribed W1/16S16 BT.

Painted blazes red and 6" red band around. Placed 54-3s, 54-9s and brass washers stamped PLS 1051 on BTs. Placed 54-2 and 54-4 on a steel fence post 5' north and 54-2 on a steel fence post 5' west of the corner.

T7SR46E  
S16


W ——— 1/16

S21  
OR PLS 1051  
1981

I hereby certify that the above corner monument was established as herein described.

Witnesses: Daniel Rowland  
Dave Poe

September 8, 1981

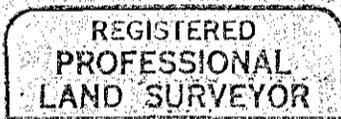

*Barry B. Barbour*

OREGON  
OCT. 17, 1973  
BARRY B. BARBOUR  
1031

Office of...County Surveyor..... County of...Baker.....  
State of...Oregon..... I hereby certify that the within instrument was filed in this office  
for record on the...7<sup>th</sup>...day of.....January....., 1982

.....*Barry B. Barbour*..... by .....*Tom Healy*.....  
(COUNTY OFFICIAL) (DEPUTY)

FILED Jan. 25, 1982  
BAKER COUNTY SURVEYOR  
SURVEY NO. 7-46-127