


CERTIFIED RECORD OF LAND CORNER MONUMENTATION

Index File No. 0-8

History of original corner establishment:

No history.

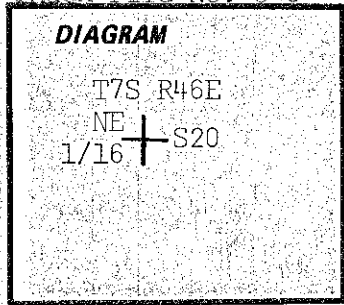

Description of corner evidence found:

None.

Description of monument and accessories established to perpetuate the original location of this corner:

At surveyed point set 2 1/2" x 30" galvanized pipe and brass cap marked:
 Set pipe 24" in the ground and mound of stones around to cap.
 From which by magnetic declination of N20°E:
 A 10" pine bears S71°E, 48.1 ft. scribed NE 1/16 S20 BT.
 An 11" pine bears N20°W, 74.0 ft. scribed NE 1/16 S20 BT.
 Painted blazes red and 6" red band around. Placed 54-3s, 54-4s, and brass washers stamped PLS 1051 on BTs. Placed 54-2 and 54-9 on a steel fence post 5' North, and 54-2 on a steel fence post 5' East of the corner.
 Corner falls on South edge of old logging road.

T7S R46E
 NE + S20
 1/16
 OR PLS 1051
 1981

I hereby certify that the above corner monument was established as herein described.

Witnesses: Daniel Rowland
Dave Poe

October 14, 1981

REGISTERED
 PROFESSIONAL
 LAND SURVEYOR

Barry B. Barbour

OREGON
 OCT. 17, 1975
 BARRY B. BARBOUR
 1031

Office of...County Surveyor..... County of...Baker.....
 State of...Oregon....., I hereby certify that the within instrument was filed in this office
 for record on the...25...day of...January....., 1982.

.....County Surveyor..... byTom Hardy.....
 (COUNTY OFFICIAL) (DEPUTY)