


CERTIFIED RECORD OF LAND CORNER MONUMENTATION

Index File No. P-7

History of original corner establishment:

None.

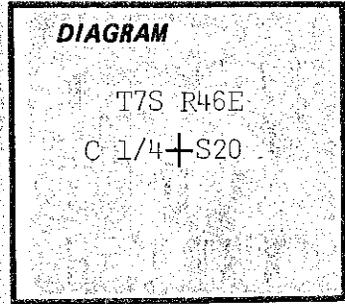

Description of corner evidence found:

None.

Description of monument and accessories I established to perpetuate the original location of this corner:

At surveyed point set 2 1/2" x 30" galvanized pipe and brass cap marked:
 Set pipe 25" in the ground and mound of stone around to cap.
 From which by magnetic declination of N20°E:
 An 11" pine bears S59°E, 25.9 ft. scribed C 1/4 S20 BT.
 An 11" pine bears N25°W, 15.1 ft. scribed C 1/4 S20 BT.
 Painted blazes red and 6" red band around. Placed 54-3s, 54-4s, and brass washers stamped PLS 1051 on BTs. Placed 54-9 on a steel fence post 5' North of the corner.

T7S R46E
 C 1/4 + S20
 OR PLS 1051
 1981

I hereby certify that the above corner monument was established as herein described.

Witnesses: Daniel Rowland
Dave Poe

October 19, 1981

**REGISTERED
 PROFESSIONAL
 LAND SURVEYOR**

Barry B. Barbour

OREGON
 OCT. 17, 1975
 BARRY B. BARBOUR
 1051

Office of.....County Surveyor..... County of..Baker.....
 State of.....Oregon....., I hereby certify that the within instrument was filed in this office
 for record on the..25.. day of.....January....., 1982.

.....*Barry B. Barbour*..... by.....*Tom Hendley*.....
 (COUNTY OFFICIAL) (DEPUTY)

FILED Jan. 25, 1982
 BAKER COUNTY SURVEYOR
 SURVEY NO. 7-46-133