


CERTIFIED RECORD OF LAND CORNER MONUMENTATION

Index File No. P-9

History of original corner establishment:

Corner was originally established under G.L.O. contract No. 443 by W. B. Barr, during August of 1882. Surveyors General's notes state: "Set basalt rock 14 x 10 x 5 ins. 10 inches in ground for 1/4 Sec. corner marked 1/4 on the West side from which: A tamarack 5 in. diam. bears N81°W, 40 lks. dist. marked 1/4 S. BT. A tamarack 6 in. diam. bears East, 16 lks. dist. marked 1/4 S. BT."

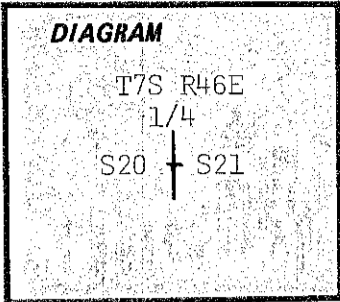

Description of corner evidence found:

Found no trace of record stone or BTs.

Description of monument and accessories I established to perpetuate the original location of this corner:

At surveyed point set 2 1/2" x 30" galvanized pipe and brass cap marked;
Set pipe 24" in the ground and mound of stone around to cap.
From which by magnetic declination of N20°E:
A 16" fir bears N57°E, 32.1 ft. scribed 1/4 S21 BT.
A 14" fir bears N71°W, 31.4 ft. scribed 1/4 S20 BT.
Painted blazes red and 6" red band around. Placed 54-3s, 54-4s, and brass washers stamped PLS 1051 on BTs. Placed 54-4 on a steel fence post 5' North of corner.

T7S R46E
1/4
S20 + S21
OR PLS 1051
1981

I hereby certify that the above corner monument was reestablished as herein described.

Witnesses: Daniel Rowland
Dave Poe

October 14, 1981

**REGISTERED
PROFESSIONAL
LAND SURVEYOR**

Barry B. Barbour

**OREGON
OCT. 17, 1975
BARRY B. BARBOUR
1051**

Office of..... County Surveyor..... County of..... Baker.....
State of..... Oregon..... I hereby certify that the within instrument was filed in this office
for record on the 25 day of January..... 1982.
..... by
(COUNTY OFFICIAL) (DEPUTY)

FILED Jan 25, 1982
BAKER COUNTY SURVEYOR
SURVEY NO. 7-46-134