


CERTIFIED RECORD OF LAND CORNER MONUMENTATION

Index File No. P-12

History of original corner establishment:

No history.

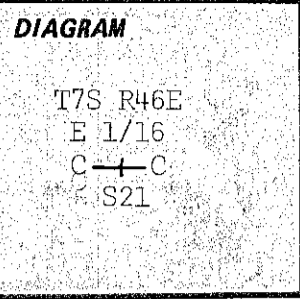

Description of corner evidence found:

None.

Description of monument and accessories established to perpetuate the original location of this corner:

At surveyed point set 2 1/2" x 30" galvanized pipe and brass cap marked;
 Set pipe 18" in the ground and mound of stones around to cap.
 From which by magnetic declination of N20°E;
 A 24" pine bears S20°E, 48.3 ft. scribed CE 1/16 S21 BT.
 A 12" pine bears N51°W, 51.0 ft. scribed CE 1/16 S21 BT.
 Painted blazes red and 6" red band around. Placed 54-3s, 54-9s, and brass washers stamped PLS 1051 on BTs. Placed 54-2 and 54-9 on a steel fence post 5' South and 54-2 on a steel fence post 5' West of the corner.

T7S R46E
 E 1/16
 C — C
 S21
 OR PLS 1051
 1981

I hereby certify that the above corner monument was established as herein described.

Witnesses: Daniel Rowland
Dave Poe

October 7, 1981

REGISTERED
 PROFESSIONAL
 LAND SURVEYOR

Barry B. Barbour

OREGON
 OCT. 17, 1975
 BARRY B. BARBOUR
 1051

Office of.....County Surveyor..... County of.....Baker.....
 State of.....Oregon..... I hereby certify that the within instrument was filed in this office
 for record on the...25... day of.....January....., 1982
 County Surveyor..... by.....Tom Handley.....
 (COUNTY OFFICIAL) (DEPUTY)

FILED Jan. 25, 1981
 BAKER COUNTY SURVEYOR
 SURVEY NO. 7-46-136