


CERTIFIED RECORD OF LAND CORNER MONUMENTATION

Index File No. R-7

History of original corner establishment:

Corner was originally established under G. L. O. contract No. 443 by W. B. Barr, during August of 1882. Surveyors General's notes state: "Set volcanic rock 12 X 8 X 7 ins. 8 inches in ground for 1/4 Sec corner, marked 1/4 on the north side, from which: A pine 28 ins. diam. bears S55°W, 86 lks. dist. marked 1/4 S BT. A pine 8 ins. diam., bears N1°E, 106 lks. dist. marked 1/4S BT."

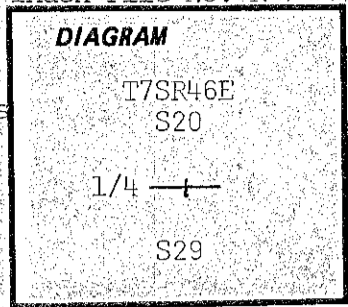

Description of corner evidence found:

Found 13 x 8 x 7 inch stone with 1/4" and 1" iron bar alongside. From which a rotten pine stump bears S55°W., 27.5 ft. and a 10' high pine snag bears N01°E., 56.7 ft.. Been cut on and too rotten to find scribing.

Description of monument and accessories I established to perpetuate the original location of this corner:

At center of above stone set 2 1/2" x 30" galvanized pipe and brass cap marked: Set pipe 24" in the ground and buried marked stone alongside.

From which by magnetic declination of N20°E:

A 12" fir bears S03°W., 10.5 ft. scribed 1/4S29 BT.

A 12" pine bears N65°W., 33.0 ft. scribed 1/4S20 BT.

Painted blazes red and 6" red band around. Placed 54-3s, 54-4s and brass washers stamped PLS 1051 on the BT. Placed 54-2 and 54-4 on a steel fence post 5' east and 54-2 on a steel fence post 5' west of the corner.

T7SR46E
S20

1/4 ———

S29
OR PLS 1051
1981

I hereby certify that the above corner monument was reestablished as herein described.

Witnesses: Daniel Rowland
Dave Poe

September 9, 1981

**REGISTERED
PROFESSIONAL
LAND SURVEYOR**

Barry B. Barbour

OREGON
OCT. 17, 1973
BARRY B. BARBOUR
1031

Office of.....County.....Surveyor..... County of.....Baker.....
State of.....Oregon..... I hereby certify that the within instrument was filed in this office
for record on the...25...day of...January....., 1982

.....County.....Surveyor..... byTom H. Hanley.....
(COUNTY OFFICIAL) (DEPUTY)

Form R6-7100-57 (9/71)

☆ GPO—798-276

FILED Jan. 25, 1982

BAKER COUNTY SURVEYOR

SURVEY NO. 7-46-138