


CERTIFIED RECORD OF LAND CORNER MONUMENTATION

Index File No. R-12

History of original corner establishment:

No history.

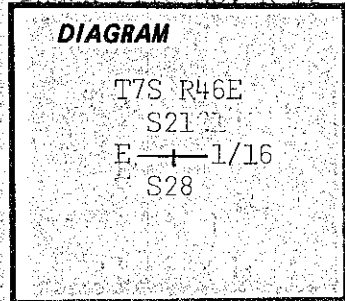

Description of corner evidence found:

None.

Description of monument and accessories established to perpetuate the original location of this corner:

At surveyed point set 2 1/2" x 30" galvanized pipe and brass cap marked:
 Set pipe 25" in the ground in large open field.
 From which by magnetic declination of N20°E:
 A 30" pine bears S80°W, 220.5 ft. scribed E 1/16 S28 BT.
 A 24" pine bears S16°W, 300.0 ft. scribed E 1/16 S28 BT.
 Painted blazes red and 6" red band around. Placed 54-3s, 54-9s, and brass washers stamped PLS 1051 on BTs. Placed 54-2 and 54-9 on a steel fence post 5' South and 54-2 on a steel fence post 5' West of the corner.
 Placed BTs on U. S. F. S. land only.

T7S R46E
 S21
 E — 1/16
 S28
 OR PLS 1051
 1981

I hereby certify that the above corner monument was established as herein described.

Witnesses: Daniel Rowland
Dave Poe

October 6, 1981

REGISTERED
 PROFESSIONAL
 LAND SURVEYOR

Barry B. Barbour

OREGON
 OCT. 17, 1975
 BARRY B. BARBOUR
 1031

Office of.....County..Surveyor..... County of.....Baker.....
 State of.....Oregon..... I hereby certify that the within instrument was filed in this office
 for record on the...25... day of.....January....., 19..82

.....County Surveyor..... byTara Hanley.....
 (COUNTY OFFICIAL) (DEPUTY)

FILED Jan 25, 1982
 BAKER COUNTY SURVEYOR
 SURVEY NO. 7-46-141