

CERTIFIED RECORD OF LAND CORNER MONUMENTATION

Index File No. S-13

History of original corner establishment:

Corner was set by Hanley Engineering in 1979, under U. S. F. S. contract. Found no trace of monument. Trees were defaced, but the red bands remained. Surveyed point falls in a filled up hole, believed to be from the monument. From which a 14" Tamarack, bears S76°E, 40.4 ft. with red band. A 12" Tamarack bears S33°W, 41.0 ft. with red band.

DIAGRAM

T7S R46E
N1/16
S28 + S27

Description of corner evidence found:

Description of monument and accessories I established to perpetuate the original location of this corner:

At surveyed point set 2 1/2" X 30" galvanized pipe and brass cap marked: Set pipe 24" in the ground and mound of stone around to cap.

T7S R46E
N1/16
S28 + S27

From which by magnetic declination of N20°E:

OR PLS 1051
1981

A 20" Pine bears N44°E, 65.5 ft. scribed N1/16 S27 BT.


A 16" Tamarack bears S11°W, 32.4 ft. scribed N1/16 S28 BT.

Painted blazes red and 6" red band around. Placed 54-3s, 54-9s, and brass washers stamped PLS 1051 on the BTs. Placed 54-2 and 54-9 on a steel fence post 5' north and a 54-2 on a steel fence post 5' west of the corner.

I hereby certify that the above corner monument was reestablished as herein described.

Witnesses: Daniel Rowland
Dave Poe

October 10, 1981

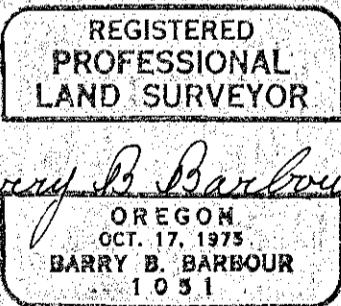

Barry B. Barbour


Office of..... County Surveyor..... County of..... Baker.....

State of..... Oregon..... I hereby certify that the within instrument was filed in this office for record on the..... 7.5. day of..... January..... 19.82

County Surveyor..... by Tom Hanley.....
(COUNTY OFFICIAL) (DEPUTY)

Form R6-7100-57 (9/71)

★ GPO - 798-276

FILED Jan. 25, 1982

BAKER COUNTY SURVEYOR

SURVEY NO. 7-46-143