


CERTIFIED RECORD OF LAND CORNER MONUMENTATION

Index File No. T-11

History of original corner establishment:

No history.

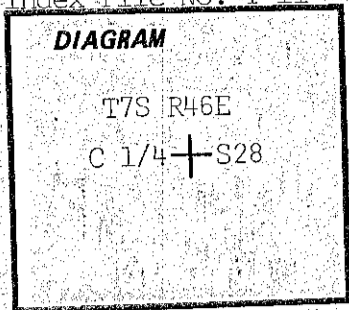

Description of corner evidence found:

None.

Description of monument and accessories established to perpetuate the original location of this corner:

At surveyed point set 2 1/2" x 30" galvanized pipe and brass cap marked:
 Set pipe 10" in the ground to bedrock and mound of stone around to cap.
 Corner falls just East of a North-South ridge with no trees.
 A North-South fence is 3' West of the corner. Placed 54-2 and 54-9 on a steel fence post 5' North and 54-2 on a steel fence post 5' East of the corner. Built 3' x 3' mound of stone 5' West of the corner.

T7S R46E
 C 1/4 + S28
 OR PLS 1051
 1981

I hereby certify that the above corner monument was established as herein described.

Witnesses: Daniel Rowland
Dave Poe

October 15, 1981

REGISTERED
 PROFESSIONAL
 LAND SURVEYOR

Barry B. Barbour

OREGON
 OCT. 17, 1975
 BARRY B. BARBOUR
 1051

Office of..... County Surveyor..... County of..... Baker
 State of..... Oregon....., I hereby certify that the within instrument was filed in this office
 for record on the... 7.5... day of... January....., 19.. 82
 County Surveyor..... by..... Tom Handley.....
 (COUNTY OFFICIAL) (DEPUTY)

Form R6-7100-57 (9/71)

☆ GPO—798-276

FILED Jan 25, 1982
 BAKER COUNTY SURVEYOR
 SURVEY NO. 7-46-144