


CERTIFIED RECORD OF LAND CORNER MONUMENTATION

Index File No. V-11

History of original corner establishment:

Corner was originally established under G. L. O. contract No. 443 by W. B. Barr, during August of 1882. Surveyors General's notes state: "Set Lava rock 12 X 10 X 8 ins., 8 ins. in ground for 1/4 Sec corner marked 1/4 on the north side and raised mound of rock alongside, pits impracticable."

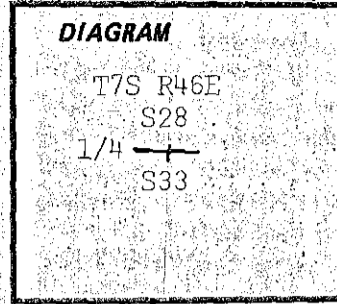

Description of corner evidence found:

Found no trace of record stone or mound of stone. Lots of rock jacks in the area.

Description of monument and accessories I established to perpetuate the original location of this corner:

At surveyed point set 2 1/2" X 30" galvanized pipe and brass cap marked: Set pipe 22" in the ground and mound of stone around to cap. No trees in the area. Built 3' X 3' mound of stone 5' West of the corner. Placed 54-4 on a steel fence post 5' East of the corner. Corner falls about 30 feet east of a north-south fence.

T7S R46E
S28
1/4
S33
OR PLS 1051
1981

I hereby certify that the above corner monument was reestablished as herein described.

Witnesses: Daniel Rowland
Dave Poe

October 8, 1981.

REGISTERED PROFESSIONAL LAND SURVEYOR

Barry B. Barbour

OREGON
OCT. 17, 1975
BARRY B. BARBOUR
1051

Office of.....County Surveyor..... County of.....Baker.....
State of.....Oregon....., I hereby certify that the within instrument was filed in this office
for record on the 25 day of January....., 1982
County Surveyor..... by.....Tom Hanley.....
(COUNTY OFFICIAL) (DEPUTY)

Form R6-7100-57 (9/71)

GPO-798-276

FILED Jan 25, 1982
BAKER COUNTY SURVEYOR
SURVEY NO. 7-46-145