


**CERTIFIED RECORD OF LAND CORNER MONUMENTATION**

**History of original corner establishment:**

Corner established by W.B. Barr under Contract No. 443, dated May 29, 1882.

**Surveyors general record states:**

Set granite boulder 14 x 10 x 5 ins., 10 inches in the ground for  $\frac{1}{4}$  sec. corner. Marked  $\frac{1}{4}$  on the West side and raised mound of rock alongside; pits impracticable.

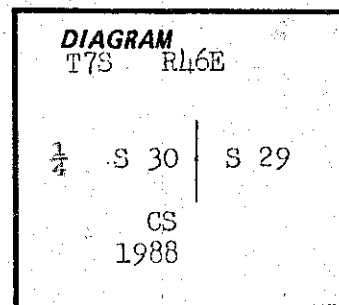

**Description of corner evidence found:**

No evidence of the original corner was found. It is believed that road construction has destroyed or buried any original evidence.

Fence lines running West and South have been extended East and North to their calculated point of intersection for the relocated corner position.

Reference is made to County Survey No. 7-46-79A for Auldin Prescott, dated Jan. 22, 1981. Monumentation for this corner was not made at that time of survey.

**Description of monument and accessories established to perpetuate the original location of this corner:**

At the calculated corner point:

Set a  $2\frac{1}{2}$  in. brass cap on a  $1\frac{1}{4}$  in. iron pipe 30 ins. into the ground. Constructed a 36 in. dia. stone mound around the pipe. The brass cap is marked as shown in the corner diagram. Set a steel fence post 4 ft. NW from the monument with a USFS 54-9 sign attached.

I certify that this monument was properly reestablished under my supervision on Oct. 3, 1988 by Tom Fisk and Larry McBroom.

Office of.....County Surveyor..... County of..... Baker  
 State of..... Oregon....., I hereby certify that the within instrument was filed in this office  
 for record on the..... day of....., 19.....  
 ..... by .....  
 (COUNTY OFFICIAL) (DEPUTY)

**REGISTERED  
PROFESSIONAL  
LAND SURVEYOR**

*James D. Hanley*  
**OREGON**  
 SEPTEMBER 23, 1977  
 JAMES D. HANLEY  
 1206