

# RECORD OF LAND CORNER MONUMENTATION

SOUTHEAST CORNER SECTION 20, T. 7 S., R. 46 E., W.M.


**ORIGINALLY ESTABLISHED BY:** W. B. Barr, U.S. Deputy Surveyor

**CONTRACT NUMBER:** 443

**CONTRACT DATE:** May 29, 1882

**SUBSEQUENT SURVEYS:**

- ▶ Survey by Barry B. Barbour, PLS 1051, filed as Survey No. 7-16-95 and corner certificate filed as Survey No. 7-46-140, recorded January 25, 1982.
- ▶ Maintained by Kenneth A. Lind, PLS 2672, corner certificate filed as Survey No. 7-46-154, recorded Nov. 6, 2009.

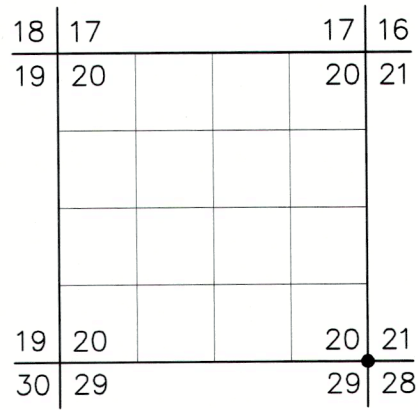

**ORIGINAL DESCRIPTION:** Set volcanic rock 15x12x10ins, 10 inches in ground for corner to Sec 20, 21, 28, 29 marked with 2 notches on the South and 4 notches on the East-edges from which a pine 18in diam bears N66°E 160 lks dist marked T7SR46ES21 B.T. No other trees within limit. Raised mound of rock alongside; pits impracticable.

**BARBOUR'S DESCRIPTION:** Found 14 x 12 x 10 inch stone firmly set and marked with 2 notches on South and 4 notches on East sides. From which: A 30" pine bears N66°E, 105.6 ft. with open blaze and visible scribing. Mound of stone West of marked stone.

At the center of the above stone set 2 1/2" x 30" galvanized pipe and brass cap marked (diagram shown): Set pipe 25" in the ground and mound of stone around to cap. Placed marked stone alongside. From which by magnetic declination of N20°E:

A 30" pine bears N87°W, 102.3 ft. scribed T7SR46E S20 BT.  
 No other trees within limits. Painted blazes red and 6" red band around. Placed 54-3, 54-4, and brass washer stamped PLS 1051 on BT. Painted old BT and placed 54-3 and 54-4. Re-built mound of stone 5' West of the corner. Placed 54-2 and 54-4 on a steel fence post 5' East and 54-2 on a steel fence post 3' West of the corner.

**LIND'S DESCRIPTION:** Found 2 1/2" diameter brass cap set flush with ground in small stone mound. Corner monument is above cutbank of old road. A stone mound 3' x 2' x 1' to West. From which:  
 A Ponderosa Pine 32" in diameter bears N66°E, 105.6' with visible scribing.  
 A Ponderosa Pine with a broken top 34" in diameter bears N87°W, 102.3' with visible scribing.  
 Both BT's have 54-3 and 54-4 signs. A steel post with 54-2 and 54-4 signs bears East, 4.0'. A steel post with 54-2 sign bears West, 2.7'.

New accessories:  
 A 5/8" x 30" rebar with a 1 1/4" diameter red plastic cap 4" above ground bears S53°E, 2.3'.  
 A 5/8" x 30" rebar with a 1 1/4" diameter red plastic cap 2" above ground bears S52°W, 4.8'.

**EVIDENCE FOUND:** Found a 2 1/2" galvanized iron pipe with 2 1/2" brass cap, marked as shown on the diagram, flush with ground, with a metal fence post with attached USFS 54-2 and 54-9 signs 3 ft., east, adjacent to east-west barbwire fenceline and on top of a cutbank of an old road.

From which the original bearing tree:  
 A ponderosa pine, 33" dbh, bears N.66°E., 105.6 ft., with double healed blaze in good condition.  
 Also from which, Barbour's bearing tree:  
 A ponderosa pine, 34" dbh, bears N.87°W., 102.3 ft., with double heal blaze, and a broken top.  
 Also from which, Lind's reference monuments:  
 A 5/8" iron rod with 1 1/4" red plastic cap, bears S.53°E., 2.3 ft.  
 A 5/8" iron rod with 1 1/4" red plastic cap, bears S.52°W., 4.8 ft.

**DESCRIPTION OF MONUMENTS AND ACCESSORIES SET AND METHODS USED:**


I accept the position of the found monument for the corner.

From which, **I SET A NEW REFERENCE MONUMENT:**

- ▶ A 5/8"x24" iron rod, bears N.62°W., 4.13 ft., with attached 2" aluminum cap marked *RM 1 2023 PLS 91693*.

Painted a 6 inch red band around each bearing tree, and also painted blazes red and attached USFS 54-3 and 54-9 signs as needed. Distances measured with steel tape. Bearings measured with a handheld compass with 14° East declination.

CORNER MONUMENT  
MARKED:

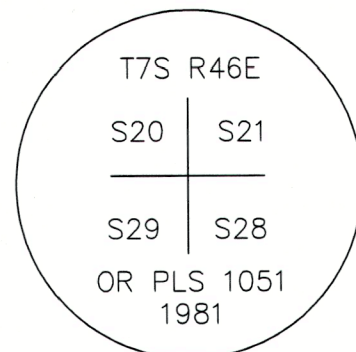

FILED January 24, 2024  
 BAKER COUNTY SURVEYOR  
 SURVEY NO. 7-46-170

# RECORD OF LAND CORNER MONUMENTATION

SOUTHEAST CORNER SECTION 20, T. 7 S., R. 46 E., W.M.

---

**RESTORATION BY, STAMP AND DATE:**

Work Performed November 14, 2023 by:

T. DeJesus Quinones, LSIT  
Vincent L. Kelly  
Spencer B. Jones

USDA FOREST SERVICE  
NORTHEAST OREGON LAND ZONE  
1550 Dewey Avenue, Suite A  
Baker City, OR 97814  
(541) 523-1281



RENEWS: 12/31/2024

FILED January 24, 2024  
BAKER COUNTY SURVEYOR  
SURVEY NO. 7-46-170