


Index
File No. N-3

CORNER RECORD (SEARCH)

Tract or
Survey No. _____ Cor. 3/4 COR.
No. SEC. 18

T 7 S R. 17 E R.D. PINE County Baker
Merid. Willamette N.F. Wallowa-Whitman State Oregon

CORNER DIAGRAM

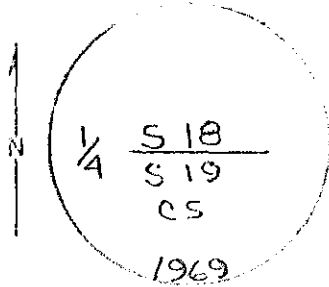

DESCRIBE CORNER MONUMENT FOUND

Original stone $\frac{1}{4}$ corner monument 12 x 8 x 6 basalt.

DESCRIBE BEARING TREES OR OTHER OFFICIAL ACCESSORIES FOUND

Found stump for sec. 18 B.T. sec. 19 B.T. is down

PHOTO IDENTIFICATION DATA

Photo No. _____
Filed At. _____
Object Ident. _____
Ident. By _____
Signature

PLANE COORDINATE POSITION DATA

State _____ Zone _____
X _____
Y _____
Estab. By _____
Agency

Signature

Title

Division

Headquarters

Date

7100-52

REV. 65 5

CORNER RECORD (PERPETUATION)

MONUMENT: DESCRIBE NEW MONUMENT SET, OR WORK DONE TO PRESERVE EXISTING MONUMENT

Set 1-inch galvanized pipe with 2-inch aluminum cap marked as shown
alongside stone.

ACCESSORIES: DESCRIBE NEW BT'S WITNESS OBJECTS ETC. ESTABLISHED, OR WORK DONE TO PRESERVE EXISTING EVIDENCE


None

Work Done By J. D. Hanley Title Engineer Date 9-69 State Registration No. Oregon P.E. 2808
or Agency _____

Certified Cor. Record Prepared? Yes No Filed At. _____ Date _____

REMARKS

SURVEY NO. 71-41-4

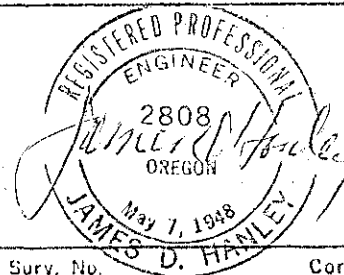

Index File No. _____ T. _____ R. _____ M. _____ Tract or Surv. No. _____ Cor. _____