


Index File No. A-21 CORNER RECORD (SEARCH) Tract or Survey No. _____ Cor. NW COR
 T 7 S R. 47 E R.D. PINE County Baker No. SEC. 1
 Merid. Willamette N.F. Wallowa-Whitman State Oregon

CORNER DIAGRAM

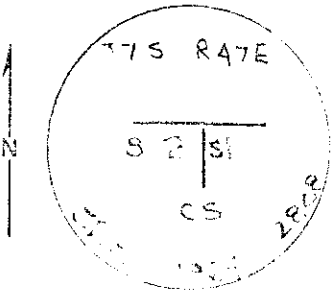

DESCRIBE CORNER MONUMENT FOUND

None

DESCRIBE BEARING TREES OR OTHER OFFICIAL ACCESSORIES FOUND

Found spurious B.T. stump 155 ft. N. and 141 ft. W. of corner location. No B.T.'s. were set during original survey.

PHOTO IDENTIFICATION DATA

Photo No. _____
 Filed At. _____
 Object Ident. _____
 Ident. By _____
 Signature _____

DESCRIBE CORNER LOCATION RELATIVE TO NEAR-BY FEATURES, ALSO HOW TO REACH CORNER

Corner located by field notes call of 1.0 chain East of Pine Creek, 3.0 chains North of top of spur. Location from physical features yields distance of 2689.5 ft. from $\frac{1}{2}$ corner between sec's. 1 and 2.

PLANE COORDINATE POSITION DATA

State _____ Zone _____
 X _____
 Y _____
 Estab. By _____
 Agency _____

Signature _____ Title _____ Division _____ Headquarters _____ Date _____ 7100-52
 REV. 65 5

CORNER RECORD (PERPETUATION)

MONUMENT. DESCRIBE NEW MONUMENT SET, OR WORK DONE TO PRESERVE EXISTING MONUMENT

Set 1-inch galvanized pipe with 2-inch aluminum cap marked as shown.

ACCESSORIES DESCRIBE NEW B.T.'s WITNESS OBJECTS ETC. ESTABLISHED, OR WORK DONE TO PRESERVE EXISTING EVIDENCE

Set B.T., 14" fir bears West 1.7 ft. marked T 7 S R 47 E S 2 B.T.
 Raised mound stone, 3 ft. base, 2 ft. high, 4 ft. East of corner

Work Done By J. D. Hanley Title Engineer Date 5-61 State Registration No. Oregon P.E., 2808
 or Agency _____

Certified Cor. Record Prepared? Yes No Filed At: _____ Date _____

REMARKS

