


CERTIFIED RECORD OF LAND CORNER MONUMENTATION

Index File No. E-9

History of original corner establishment:

Corner was originally established under GLO contract number 707, by Williard B. Blakeslee on June 16, 1901. Surveyor General's notes state: "Set a basalt stone 14 x 10 x 6 ins. for the cor. to secs. 4-5-8 & 9, marked with 5 notches on the S. and 4 on E. faces from which a pine tree 14 ins. in diam. brs. S85°W. 40 lks. dist. marked T7S R47E S8 BT and no other trees within limits. Raised a mound of stone 3 ft. base 22 ins. high 10 lks. W. of the cor."

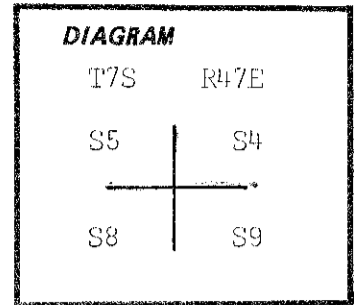


Description of corner evidence found:

Found 14 x 12 x 5 inch stone, clearly marked with 2 notches, 4 notches and 5 notches on three sides. From which a 3 1/4" pine bears S66°W., 26.1 ft. with grown-over blazes.

Description of monument and accessories established to perpetuate the original location of this corner:

At the center of the above point, set 2 1/2" x 30" galvanized pipe and brass cap marked as shown. Set pipe 22" in the ground and mound of stone around to cap. Buried marked stone alongside of the pipe.

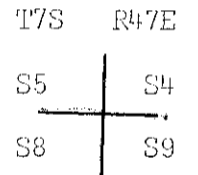


From which by magnetic declination of N20°E:
 A 16" fir bears N35°E., 8.0 ft., scribed T7S, R47E, S4 BT.
 A 15" pine bears S40°E., 46.3 ft., scribed T7S, R47E, S9 BT.
 A 15" pine bears N43°W., 29.6 ft., scribed T7S, R47E, S5 BT.
 Painted blazes red and 6" red band around.
 Placed 54-3s, 54-4s, and brass washers stamped PLS 1051 on the BT's. Placed 54-4 on a steel fence post 5 ft. North of the corner.

OR PLS 1051
1981


I hereby certify that the above corner monument was reestablished as herein described.

Witnesses: Daniel Rowland
Beverly Weaselhead

June 2, 1981

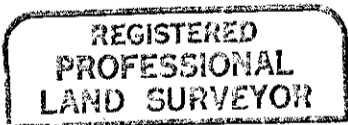

Barry B. Barbour

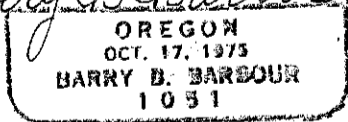

Office of.....County Surveyor..... County of..... Baker.....
 State of..... Oregon....., I hereby certify that the within instrument was filed in this office
 for record on the..... day of..... June....., 19..81
 by
 (COUNTY OFFICIAL) (DEPUTY)

Filed July 27, 1981
 Baker County Office
 7-47-11