


CERTIFIED RECORD OF LAND CORNER MONUMENTATION

History of original corner establishment:

Index File No. L-5

Corner was originally established under G. L. O. contract number 707, by Williard B. Blakeslee on August 3, 1901. Surveyor General's notes state: "Set a granite stone 16 x 10 x 8 ins., 10 ins. in the grnd. for 1/4 sec. cor., marked 1/4 S on the W. face. Raised a mound of stone 3 ft. base 22 ins. high, 10 lks. W. of the cor. "

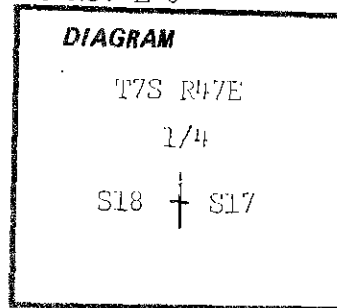

Description of corner evidence found:

Found 15 x 12 x 9 inch stone, firmly set and dimly marked 1/4 S. with large mound of stone 6.5 ft. west of the stone.

Description of monument and accessories established to perpetuate the original location of this corner:

At the center of the surveyed point, set 2 1/2" x 30" galvanized pipe and brass cap marked: Set pipe 25" in the ground and mound of stone around to cap. Buried marked stone alongside of the pipe.

From which by magnetic declination of N20°E:

A 26" Pine bears S57°E., 65.8 ft. scribed 1/4 S17 BT.

A 15" Pine bears N85°W., 21.3 ft. scribed 1/4 S18 BT.

Painted blaze red and 6" red band around.

Placed 54-3s, 54-4s, and brass washers stamped PLS 1051 on the BT's.

Placed 54-4 on a steel fence post 5' north of the corner.

T7S R47E

1/4

S18 + S17


OR PLS 1051

1981

I hereby certify that the above corner monument was reestablished as herein described.

Witnesses: Daniel Rowland

April 23, 1981

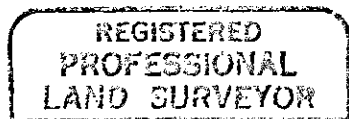

Barry B. Barbour

OREGON
OCT. 17, 1973
BARRY B. BARBOUR
1981

Office of.....County Surveyor.....County of.....Baker
Oregon
Stats of....., I hereby certify that the within instrument was filed in this office
for record on the.....day of.....1981