


CERTIFIED RECORD OF LAND CORNER MONUMENTATION

Index File NO. N-3

History of original corner establishment:

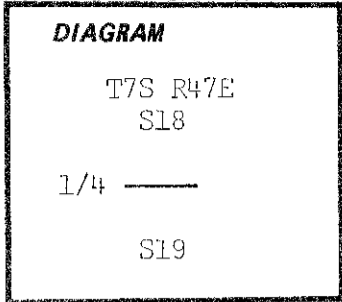

Corner was originally established under G.L.O. contract number 707, by Williard B Blakeslee on August 3, 1901. Surveyor General's notes state: "Set a basalt stone 12x8x6 ins 8 ins. in the grd. for 1/4 sec cor., marked 1/4S on the N. face from which a pine tree 20 ins. in diam., bears N1°W., 35 lks. dist. marked 1/4 S18 BT. and a pine 12 ins. in diam., brs. S55°W., 31 lks dist marked 1/4 S19 BT.

Description of corner evidence found:

Found 1" aluminum pipe with 2" aluminum cap projecting 5" above the ground, with mound of stone around to cap. Cap Stamped:

S18

1/4 ———

From which a burnt stump bears N01°E., 24.4 Ft. dist., no visible scribing.

S19

24" stump. 54-3 was attached to stump.

CS


1969

Description of monument and accessories I established to perpetuate the original location of this corner:

From which by magnetic declination of N20°E. I add: 10" pine bears N26°E., 39.0 ft. scribed 1/4 S18 BT. 10" Fir bears S42°E., 18.7 ft. scribed 1/4 S19 BT. Painted blazes red and 6" red band around. Placed 54-3s, 54-4s, and brass washers stamped PLS 1051. Placed 54-2 and 54-4 on a steel fence post 5' south and 54-2 on a steel fence post 5' East of the corner.

I hereby certify that the above corner monument was reestablished as herein described.

Witnesses: David Cummins
 Brian Cays
 Douglas Moser

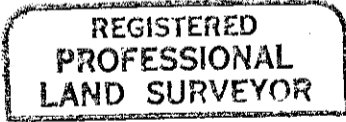

Barry B. Barbour
OREGON
OCT. 17, 1975
BARRY B. BARBOUR
1051

April 24, 1981

Office of...County...Surveyor..... County of.....Baker.....
State of.....Oregon....., I hereby certify that the within instrument was filed in this office
for record on the..... day of.....July....., 1981
..... by *Thomas G. Stennett*
(COUNTY OFFICIAL) (DEPUTY)

FILED July 27, 1981
BAKER COUNTY SURVEYOR
SURVEY NO. 7-47-22