


CERTIFIED RECORD OF LAND CORNER MONUMENTATION

Index File No. N-5

History of original corner establishment:

Corner was originally established under G. L. O. contract number 707, by Williard B. Blakeslee on August 3, 1901. Surveyor General's notes state: " Set a lava stone 16 x 10 x 8 ins., 10 ins. in the ground for cor., to secs. 17, 18, 19 and 20 marked with 3 notches on the S. and 5 on the E. faces, raised a mound of stone 3 ft. base 24 ins. high 10 lks W. of the corner."

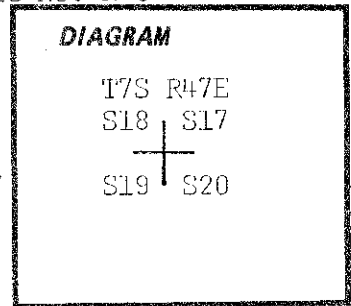


Description of corner evidence found:

Found no trace of record stone or mound after several hours of searching.

Description of monument and accessories established to perpetuate the original location of this corner:

At the center of surveyed point, set 2 1/2" x 30" galvanized pipe and brass cap marked: Set pipe 16" in the ground and mound of stone around to cap. From which by magnetic declination of N20°E: A 16" Pine bears S30°W., 316.4 ft. scribed T7S R47E S19 Bl. No other trees within limits. Painted blazes red and 6" red band around. Placed 54-3s, 54-4s, and brass washers stamped PLS 1051 on the Bls. Placed 54-2 and 54-4 on a steel fence post 5' south and placed 54-2 on a steel fence post 5' west of the corner.

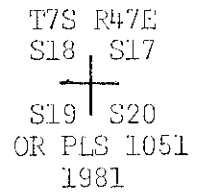

I hereby certify that the above corner monument was reestablished as herein described.

Witnesses: Daniel Rowland
Douglas Moser

April 30, 1981



Barry B. Barbour
OREGON
OCT. 17, 1975
BARRY B. BARBOUR
1051

Office of...County...Surveyor..... County of...Baker.....
State of...Oregon....., I hereby certify that the within instrument was filed in this office
for record on the..... day of....., 1981.
..... by *Thomas J. Hanley*.....
(COUNTY OFFICIAL) (DEPUTY)

FILED July 27, 1981
BAKER COUNTY SURVEYOR
SURVEY NO. 7-47-23