


CERTIFIED RECORD OF LAND CORNER MONUMENTATION

Index File No. N-13

History of original corner establishment:

Corner was originally established under G. L. O. contract number 707, by Williard B. Blakeslee on June 11, 1901. Surveyor General's notes state: "Falls on solid basalt rock in place, 24 X 12 X 12 ins., above grnd., for the cor. to secs. 15, 16, 21 & 22. I cut a cross (+) at exact cor. pt. and marked 3 notches on the S. & E. faces from which a pine 16 ins. in diam. brs. N75°W, 290 lks. dist. marked T7S R47E S16 BT and a pine 18 ins. in diam. brs. S25°30'E, 178 lks. dist. marked T7S R47E S21 BT. No other trees within limits, raised a mound of stone 3 ft. base, 23 ins. high, 10 lks. west of the corner."

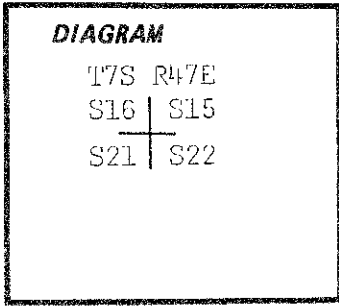

Description of corner evidence found:

Found no trace of record stone. Area is on steep north slope and found no rock projecting even 6" above the ground. Found no trace of a BT in the SE quadrant. From temporary point, surveyed to computed point on line, from which a 26" pine bears S63°W, 118.5 ft. Opened tree and found full scribe, including S21. (Notes state SE bearing, but S21 Scribe. This tree is not visible from record bearing and distance of the other record tree. Measuring to the southwest tree is almost horizontal and the other tree is on a 27° slope. From this point a 30" pine bears N65°W, 139.2 ft. horz. and 155.2 ft. slope. This is 210 lks. distance.

Description of monument and accessories I established to perpetuate the original location of this corner:


At the center of the above point, set 2 1/2" X 30" galvanized pipe and brass cap marked: Set pipe 24" in the ground and mound of stone around to cap. Built a mound of stone 3' X 3', 5 ft. east of the corner. From which by magnetic declination of N20°E: A 16" pine bears N65°E, 41.9 ft. scribed T7S R47E S15 BT. Painted blazes red and 6" red band around. Placed 54-3, 54-4 and brass washer stamped PLS 1051 on the BT. Placed 54-3 and 54-4 on the old BT's. Placed 54-2 and 54-4 on a steel fence post 5' north and placed 54-2 on a steel fence post 5' west of the corner.

T7S R47E
S16 | S15
+
S21 | S22
OR PLS 1051
1981

I hereby certify that the above corner monument was reestablished as herein described.

Witnesses: Daniel Rowland
Douglas Moser

February 11, 1981

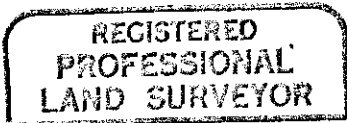

Barry B. Barbour
OREGON
OCT. 17, 1975
BARRY B. BARBOUR
1031

Office of.....County Surveyor..... County of..... Baker
State of.....Oregon....., I hereby certify that the within instrument was filed in this office for record on the..... day of....., 1981.
..... by
(COUNTY OFFICIAL) (DEPUTY)

FILED July 27, 1981
BAKER COUNTY SURVEYOR
SURVEY NO. 7-47-27